

LA 00. MISSISSIPPI BOARD OF WATER COMMISSIONERS

~~F~~ 011 WATER WELL DRILLERS LOG

Date: 8-16-61, 1951, Driller: M. J. Donald & Hill, Inc County Lauderdale
(Name)

(1) Owner of Land: Martin Shuler
(Name)
Rt. #7, Mendocan, Miss
(Address)

(2) Location: 1/4, 1/4, Sec. 22 T R
15 miles S.E. of Mendocan
(distance) (direction) (Nearest Town)

(3) Topography: (Hilly) (Flat) (Level)

(4) Purpose of Well: Domestic
(Domestic Irrigation, Municipal, Industrial, Other)

Description & Color of Materials Sand, Clay, Red Clay, Shell, etc.	Thick- ness Feet	Depth Feet
Clay	0	10
Sand	10	14
Clay	14	22
Shale	22	50
Sandy lime shale	50	58
yellow clay	58	75
Soft shale	75	90
Sand Rock	90	91
yellow sand	91	103
Shale	103	120
Soft sandy shale	120	150
Blue shale	150	164
Soft. Brown shale	164	170
Sandy shale	170	178
St. shale	178	185
Soft shale	185	195
Med shale	195	205
Sandy shale	205	220
Med. shale st. sand	220	240
Sandy shale	240	252
finer sand	252	260
Shale st. sand	260	266
Shale	266	272
Rock	272	315
Shale	315	325
Sand		

Information upon completion of well:

(1) Diameter 3 inches.

(2) Total Depth 330 feet.

(3) Water Level 126 feet below top of ground.

(4) Cased to 189, Size 3'


(5) Screen: Size none, Length _____

(6) Were any formations sealed against pollution?
 yes, no.

If YES depth of formation _____

Why _____

Drillers Remarks: _____

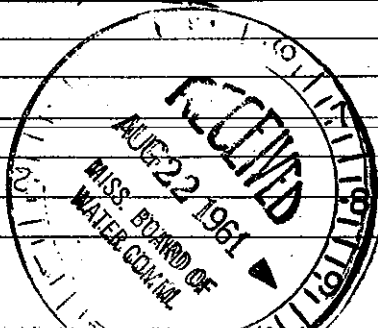

Well N