

LAUD.

MISSISSIPPI BOARD OF WATER COMMISSIONERS

U 13

WATER WELL DRILLERS LOG

5-8-65

Date: 5-8, 1965, Driller: Behr Williams County Laud  
(Name)

(1) Owner of Land:	Description & Color of Materials Sand, Clay, Red Clay, Shell, etc.	Thick- ness Feet	Depth Feet
<u>Elmer Willis</u> (Name) <u>Whynot, Miss</u> (Address)	<u>Mid yellow sand</u>		
(2) Location: <u>1/4</u> , <u>1/4</u> , Sec. <u>8</u> T. <u></u> R. <u></u>	<u>2 Blue clay</u>	<u>170</u>	<u>1-170</u>
<u>1.5</u> miles <u>East</u> , of <u>Wicks</u> (distance) (direction) (Nearest Town)	<u>Rock</u>	<u>8</u>	<u>170-178</u>
(3) Topography: <u>hilly</u> (Hilly) (Flat) (Level)	<u>sand</u>	<u>13</u>	<u>178-191</u>
(4) Purpose of Well: <u>domestic</u> (Domestic Irrigation Municipal, Industrial, Other)			

Information upon completion of well:

(1) Diameter 2 inches.

(2) Total Depth 191 feet.

(3) Water Level 85 feet below top of ground.

(4) Cased to 176, Size 2"


(5) Screen: Size \_\_\_\_\_, Length \_\_\_\_\_.

(6) Were any formations sealed against pollution?  
 yes, \_\_\_\_\_ no.

If YES depth of formation \_\_\_\_\_

Why surface water

Drillers Remarks: \_\_\_\_\_

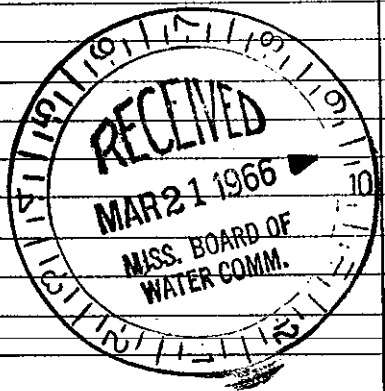

(Use Back Side)

tain this copy for your office files.