

MISSISSIPPI BOARD OF WATER COMMISSIONERS

LAUD.
U33
8-11-60

WATER WELL DRILLERS LOG

CODED

Date: 8-11, 1960, Driller: McDonald Hill County Lauderdale
(Name)


(1) Owner of Land: Robert Butler
(Name)
R# 7 Meridian
(Address)
(2) Location: 30 518
20 miles South of Meridian
(distance) (direction) (Nearest Town)
(3) Topography: X
(Hilly) (Flat) (Level)
(4) Purpose of Well: Domestic
(Domestic Irrigation, Municipal, Industrial, Other)

Description & Color of Materials Sand, Clay, Red Clay, Shell, etc.	Thick- ness Feet	Depth Feet
Clay	0	10
Red sand	10	20
Sandy clay	20	35
Shale	35	55
Clay	55	63
fine sand	63	75
shale	75	108
fine sand	108	112
mid shale	112	190
soft mud	190	240
fine sand	240	250
soft mud	250	300
mid shale	300	350
pebbles	350	351
soft mud	351	365
sandy shale	365	380
fine sand	380	390

Information upon completion of well:

(1) Diameter 3" inches.
(2) Total Depth 390' feet.
(3) Water Level 200' feet below top of ground.
(4) Cased to 168', Size 5"
(5) Screen: Size _____, Length _____
(6) Were any formations sealed against pollution?
_____ yes, X no.
If YES depth of formation _____
Why _____
Drillers Remarks: _____

CODED

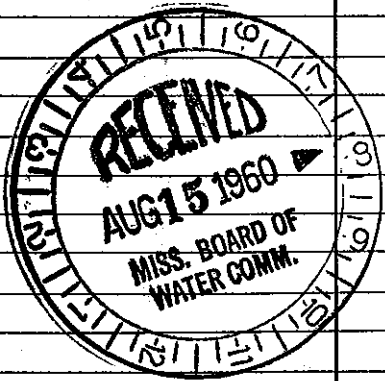

(Use Back Side)

Well No.

Mail this copy to Board of Water Commissioners 429 Miss. St. Jackson, Miss.