

MISSISSIPPI BOARD OF WATER COMMISSIONERS

LAUD.

U. 35

WATER WELL DRILLERS LOG

CODED

12-6-61

Date: 12-6, 1961, Driller: M^e. Donald H. County, Kendenale
(Name)

(1) Owner of Land: Kison obator
(Name)
Rt #6, manidia, miss
(Address)

(2) Location: 1/4, 1/4, Sec 19 518
T R

2 miles South, of Whipart
(distance) (direction) (Nearest Town)

(3) Topography: Hilly
(Hilly) (Flat) (Level)

(4) Purpose of Well: Domestic
(Domestic Irrigation
Municipal, Industrial, Other)

Description & Color of Materials Sand, Clay, Red Clay, Shell, etc.	Thick- ness Feet	Depth Feet
<u>Clay</u>	<u>0</u>	<u>14</u>
<u>Sandy clay</u>	<u>14</u>	<u>45</u>
<u>manl</u>	<u>45</u>	<u>85</u>
<u>Rock</u>	<u>85</u>	<u>89</u>
<u>Soft manl</u>	<u>89</u>	<u>95</u>
<u>Soft sandy manl</u>	<u>95</u>	<u>140</u>
<u>Sandy shale</u>	<u>140</u>	<u>195</u>
<u>Fine sand</u>	<u>195</u>	<u>220</u>

Information upon completion of well:

(1) Diameter 3 inches.

(2) Total Depth 220 feet.


(3) Water Level 70' feet below top of ground.

(4) Cased to 86, Size 3"

(5) Screen: Size none, Length _____

(6) Were any formations sealed against pollution?
_____ yes, no.

CODED

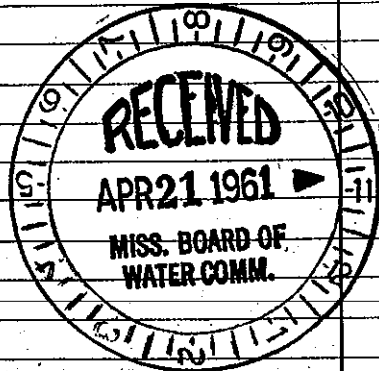

If YES depth of formation _____

Why _____

Drillers Remarks: _____

(Use Back Side)

Well No.

Mail this copy to Board of Water Commissioners 429 Miss. St. Jackson, Miss.