

LAND.

MISSISSIPPI BOARD OF WATER COMMISSIONERS

U37

WATER WELL DRILLERS LOG

CODED

10-19-62

Date: 10/19, 1962, Driller: MCDONALD & HILL, Inc County: Lauderdale

(Name)

(1) Owner of Land: J. L. Tonia
 (Name)
Rt # 7 Meridian
 (Address)

(2) Location: $\frac{1}{4}$, 20, Sec. 5 T. 18 R. 18
15 miles SE of Meridian
 (distance) (direction) (Nearest Town)

(3) Topography: _____
 (Hilly) (Flat) (Level)

(4) Purpose of Well: Domestic
 (Domestic Irrigation, Municipal, Industrial, Other)

Description & Color of Materials Sand, Clay, Red Clay, Shell, etc.	Thick- ness Feet	Depth Feet
Sandy Clay	0	18
Sand	18	23
White clay	23	27
B. shale	27	32
Red sand	32	55
B. shale	55	119
fine sand	119	135
Sandy shale	135	145
Hard shale	145	180
✓	180	210
Sand	210	215
fine sand	215	245
✓	245	270

Information upon completion of well:

(1) Diameter: 4 inches.

(2) Total Depth: 270 feet.


(3) Water Level: 84 feet below top of ground.

(4) Cased to: 189, Size: 4

(5) Screen: Size _____, Length _____

(6) Were any formations sealed against pollution?
 _____ yes, _____ no.

CODED

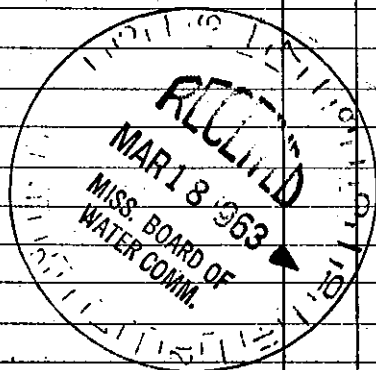

If YES depth of formation _____

Why _____

Drillers Remarks: _____

Well No.

(Use Back Side)

Retain this copy for your office files.