

LAUD.
U.38
9-27-63

WATER WELL DRILLERS LOG

CODED

Date: 4. 27., 1963, Driller: JAMES MATLOCK ENDERDALE
(Name)

(1) Owner of Land JAMES POTLEGE
(Name)
R#7 MERIDIAN
(Address)

(2) Location: 1/4, 1/4, Sec. 34 T. 18
20 miles EAST of MERIDIAN
(distance) (direction) (Nearest Town)

(3) Topography: (Hilly) (Flat) (Level)

(4) Purpose of Well: DOMESTIC
(Domestic Irrigation
Municipal, Industrial, Other)

Description & Color of Materials Sand, Clay, Red Clay, Shell, etc.	Thick- ness Feet	Depth Feet
<u>CLAY SAND</u>	<u>0</u>	<u>35</u>
<u>SHALE</u>	<u>35</u>	<u>90</u>
<u>ROCK</u>	<u>90</u>	<u>93</u>
<u>SHALE ST SAND</u>	<u>93</u>	<u>190</u>
<u>SHALE</u>	<u>190</u>	<u>250</u>
<u>SAND</u>	<u>250</u>	<u>285</u>
<u>SHALE</u>	<u>285</u>	<u>291</u>
<u>ROCK</u>	<u>291</u>	<u>292</u>
<u>SANDY SHALE</u>	<u>292</u>	<u>320</u>

Information upon completion of well:

(1) Diameter 4" inches.

(2) Total Depth 320' feet.

(3) Water Level 190' feet below top of ground.

(4) Cased to 210', Size 4"

(5) Screen: Size _____, Length _____


(6) Were any formations sealed against pollution?
_____ yes, no.

If YES depth of formation _____

Why _____

Drillers Remarks: _____

CODED

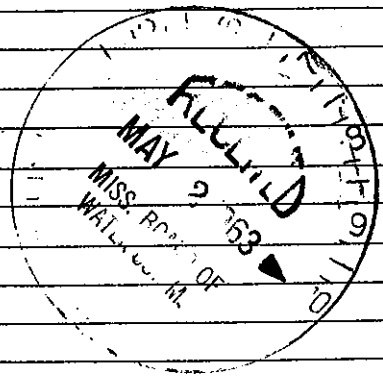

Well No.

(Use Back Side)

Mail this copy to Board of Water Commissioners 429 Miss. St. Jackson, Miss.