

LAUD.
U39

Date: April 8, 1964, Driller: Bob Williams County Mississippi
(Name)

CODED

(1) Owner of Land: Burwayne Shirley
(Name)
Rt. 7 Box 158 A Menden
(Address)

(2) Location: NE 1/4, NE 1/4, Sec. 12, T. 45 N., R. 18 W.
18 miles East of Menden
(distance) (direction) (Nearest Town)

(3) Topography: Hilly
(Hilly) (Flat) (Level)

(4) Purpose of Well: Domestic
(Domestic Irrigation
Municipal, Industrial, Other)

Description & Color of Materials Sand, Clay, Red Clay, Shell, etc.	Thick- ness Feet	Depth Feet
<u>Red Sand</u>	<u>7.5</u>	<u>1-7.5</u>
<u>Blue clay</u>	<u>4.5</u>	<u>7.5-12.0</u>
<u>Gray sand</u>	<u>2.0</u>	<u>12.0-14.0</u>
<u>Blue clay</u>	<u>7.2</u>	<u>14.0-21.2</u>

Information upon completion of well:

(1) Diameter 2 inches.

(2) Total Depth 212 feet.

(3) Water Level 84 feet below top of ground.

(4) Cased to 105, Size 2 in.

(5) Screen: Size 20, Length _____


(6) Were any formations sealed against pollution?
X yes, _____ no.

If YES depth of formation 1-7.5 ft.

Why surface water

Drillers Remarks:

CODED

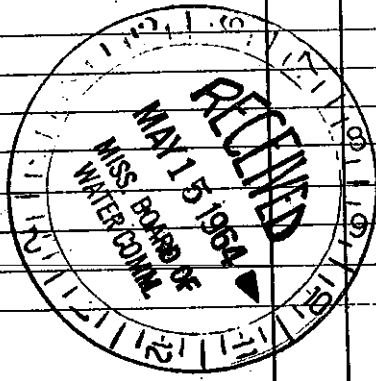

Well No.

(Use Back Side)

Mail this copy to Board of Water Commissioners 429 Miss. St. Jackson, Miss.