

LAUDERDALE

U53

9-5-73

MISSISSIPPI BOARD OF WATER COMMISSIONERS 416 North State Street Jackson, Mississippi 39201

CODED

WATER WELL DRILLERS LOG

9-5-73 date well completed

Williamson Drilling Co. firm name

Lauderdale county well located

LANDOWNER: Wm. Rainer

216 Boggs Members Inc. (mailing address)

description of formations encountered

from to

top soil	0	2
red clay	2	12
red sand	12	35
blue clay	35	107
mixed sand & clay	107	180
blue clay	180	320
mixed sand & clay	320	445
sand	445	462

WELL LOCATION:


sec. 33 T. 50 N. R. 18 E. S. 20 miles S.E. of Meridian (distance) (direction) (nearest town)

WELL PURPOSE: Home (home, irrigation, municipal, industrial)

WELL COMPLETION DATA:

- (1) diameter (inches) 4
- (2) total depth (feet) 462
- (3) static water level (feet) 235 below top of ground
- (4) casing metal 298 (material) (depth) 4 (size) If telescope see back.
- (5) screen no (length) (depth to top)
- (6) pump 3/4 (HP) 9 (material) (yield gpm) Elect. (type power)
- (7) electric log no (yes or no) no (organization running log)
- (8) how well bottom plugged open

CODED

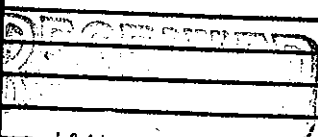

JAN 31 1974

DRILLERS REMARKS:

MISS. BD. OF WATER COMM