

LAUDERDALE

U55

5-8-74

MISSISSIPPI  
BOARD OF WATER COMMISSIONERS  
416 North State Street  
Jackson, Mississippi 39201

CODED

WATER WELL DRILLERS LOG

5. 8. 74

date well completed

McDONALD + HILL

firm name

LAUDERDALE

county well located

LANDOWNER:

HAROLD ROBERTS

Rt # 6 Meridian

(mailing address)

WELL LOCATION:

sec. 8 T. 5 N R. 18 E

1 miles EAST of Why NOT  
(distance) (direction) (nearest town)

WELL PURPOSE:

HOME (home, irrigation, municipal, industrial)

WELL COMPLETION DATA:


- (1) diameter (Inches) 4"
- (2) total depth (feet) 400'
- (3) static water level (feet) 250' below top of ground.
- (4) casing PVC 210' (material) (depth)  
4" (size) if telescope see back.
- (5) screen (length) (depth to top)  
(size) (material)
- (6) pump 3/4 HP 5 (HP) (yield gpm)  
E (type power)
- (7) electric log (yes or no)  
(organization running log)
- (8) how well bottom plugged OPEN

description of formations encountered

from to

CLAY SAND	0	30
Shale	30	60
Sandy	60	90
Shale	90	210
SANDY ST. SHALE	210	260
SOFT SANDY SHALE	260	340
SHALE	340	350
SAND ST. SHALE	350	400

CODED

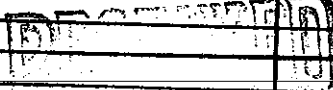

MAY 20 1974

DRILLERS REMARKS: