

MISSISSIPPI BOARD OF WATER COMMISSIONERS

WATER WELL DRILLERS LOG


Date: July 13, 1966, Driller: Nic Fitzgerald County Lauderdale
 (When well drilled) (Name) (Where well is located)

1) Owner of Land: <u>Howard Alexander</u> (Name)		Description & Color of Materials Sand, Clay, Red Clay, Shell, etc.	Thick- ness Feet	Depth Feet
<u>Jayess</u> (Address)		<u>Top Soil</u>	<u>0</u>	<u>20</u>
2) Location: $\frac{1}{4}$, $\frac{1}{4}$ Sec. <u>T</u> , R <u>R</u>		<u>Red Sand</u>	<u>20</u>	<u>60</u>
<u>3</u> miles <u>E</u> of <u>Jayess</u> (distance) (direction) (Nearest Town)		<u>Chalk</u>	<u>60</u>	<u>80</u>
3) Topography: <input checked="" type="checkbox"/> (Hilly) <input type="checkbox"/> (Flat) <input type="checkbox"/> (Level)		<u>fine sand</u>	<u>80</u>	<u>95</u>
4) Purpose of Well: <input checked="" type="checkbox"/> (Domestic Irrigation) <input type="checkbox"/> (Municipal, Industrial, Other)		<u>White Chalk</u>	<u>95</u>	<u>105</u>
		<u>Coarse Sand/gravel</u>	<u>105</u>	<u>120</u>
		<u>Heavy gravel</u>	<u>120</u>	<u>130</u>

Information upon completion of well:

1) Diameter 4 inches.
 2) Total Depth 129 feet.
 3) Water Level 80 feet below top of ground.
 4) Cased to 121, Size 4
 5) Screen: Size 4, Length 8'
 6) Were any formations sealed against pollution?
 _____ yes, no.

YES depth of formation _____
 Why _____
 Drillers Remarks: _____
 Yield in gpm: _____
 Size pump: 1/2 Submersible
 Type power: Electric

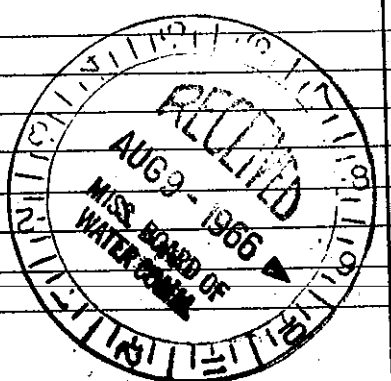

Mail this copy to Board of Water Commissioners 429 Miss. St. Jackson, Miss.