

MISSISSIPPI BOARD OF WATER COMMISSIONERS

8-7-65

OK GER

WATER WELL DRILLERS LOG

CODED

Date: 8-7, 1965, Driller: Jay Lath County Simpson

Hattiesburg ^(Name) Butane Gas

(1) Owner of Land:

M. W. Buckley
(Name)

(Name)

New Lebanon, N.H.

(Address)

(2) Location: _____ 1/4, _____ 1/4, Sec. 8 T 9 R 22

Description & Color of Materials
Sand, Clay, Red Clay, Shell, etc.

**Thick
nose
Feet**

Depth
Feet

0-35 Rc

35-100 RS

100 - 152 WC

152-173 WS

_____ miles _____, of _____,
(distance) (direction) (Nearest Town)

(3) Topography:

(Hilly)

(Flat)

(Level)

(4) Purpose of Well:

Domestic

(Domestic Irrigation
Municipal, Industrial, Other)

Information upon completion of well:

(1) Diameter 2 inches.

(2) Total Depth 173 feet.

(3) Water Level 156 feet below top of ground.

(4) Cased to _____, Size _____

(5) Screen: Size 2", Length 10'

(6) Were any formations sealed against pollution?

_____ yes, _____ no.


If YES depth of formation_____

Why _____

Drillers Remarks:_____

To be located
by Board

JES

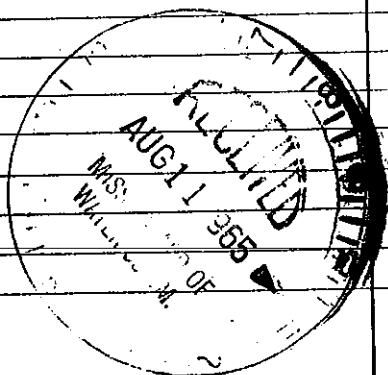

(Use Back Side)

Well No.

1 this copy to Board of Water Commissioners 429 Miss. St. Jackson. Miss