

Lawrence
E 25
4-25-81

MISSISSIPPI DEPARTMENT OF NATURAL RESOURCES
 Bureau of Land and Water Resources
 Southport Mall
 P.O. Box 10631
 Jackson, Mississippi 39209
WATER WELL DRILLERS LOG

CODED

Griner Drilling Service, Inc. Lawrence
 firm name county well located

4-25-81
 date well completed


LANDOWNER:
Exeter Drilling
2635 Bank of New Orleans
1010 Common Street
New Orleans, La

description of formations encountered	from	to
<u>sand - pea gravel</u>	<u>0</u>	<u>257</u>
<u>rock - sand</u>	<u>257</u>	<u>273</u>

WELL LOCATION: 1500' N & 1500' W
 No. 14 sec. 8 T. 8 N. R. 20 E. of
R. E. Longino Grange Field
 (distance) (direction) (nearest town)

WELL PURPOSE: oil field
 (home, irrigation, municipal supply)

- WELL COMPLETION DATA:
- (1) diameter (inches) 4"
 - (2) total depth (feet) 273'
 - (3) static water level (feet) 50' below top of ground
 - (4) casing Steel, 252'
 (material) (depth)
3"
 (size) if telescope see back.
 - (5) screen 42', 210'
 (length) (depth to top)
3", perforated
 (size) (material)
 - (6) pump —, 80
 (HP) (yield gpm)
AC
 (type power)
 - (7) electric log —
 (yes or no)
 - (organization running log)
 - (8) how well bottom plugged orange
peel

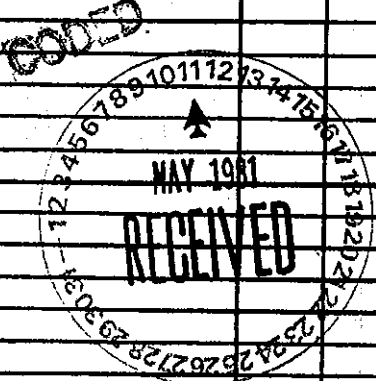

DRILLERS REMARKS: