

State Well Report

Part I

Mississippi Department of Environmental Quality
Office of Land and Water Resources
P.O. Box 10631
Jackson, MS 39289-0631
(601)961-5210
(601)354-6938 (fax)

For Office Use Only:

Aquifer: _____
Well #: E-44
L. S. Elevation: _____
E-log #: _____

County: LAWRENCE
Permit #: _____
Driller: JAMES WELLS
Date drilling completed: 9-15-06

State Law requires that this report be prepared by the driller in detail and filed with the Department within 30 days of completion of drilling of the well.

Well Owner Information	Well Location
Owner Name: <u>Charles Gatt</u>	Latitude: _____ Longitude: _____
Mailing Address: <u>P.O. Box 289</u> <u>New Hebron, MS 39140</u>	Method of Lat/Long (circle one): Conventional Survey, USGS quad, Hand-held GPS, Survey-grade GPS
City: _____ State: _____ Zip Code: _____	_____ 1/4 _____ 1/4 Sec. <u>4</u> Twp. <u>20N</u> Rng. <u>8W</u>
Telephone No. <u>(601) 886-7817</u>	Distance _____ Direction _____ Nearest Town _____ <u>5</u> Miles <u>SW</u> of <u>New Hebron</u>

Well Data

Purpose of Well (circle one) Home Industrial Public Supply Irrigation Fish Culture Other: _____

Date well drilling started: 9-15-06 Date well drilling completed: 9-15-06

If flowing, method of flow regulation: Valve _____ Other (describe) _____

Static Water Level: 150 feet above or below (circle one) land surface Date measured: 9-15-06

Method of Measurement (circle one) steel tape electric tape air line other: _____

Hole depth: 220 Well depth: 220 Well grouted to a depth of 10 feet

Type of grout (circle one): Cement Bentonite Mix

Casing length: 200 feet Casing diameter: 4 inches Type of casing: PVC

Screen length: 20 feet Screen diameter: 4 inches Type of screen: PVC

Screen slot size: 008 inches Setting depth: From 200 feet to 220 feet

Type of completion (circle all applicable): Gravel packed Underreamed Telescoped Open hole Natural Development

Other (describe): _____

Top of lap pipe or reduction in casing: _____ feet. If telescoped or more than one screen, describe on back of page

Logs run (circle all applicable): No log run Electric Gamma Ray Density Sonic Neutron Other: _____

Name of organization running log(s): _____

I certify that the well was drilled, constructed, and completed in accordance with all applicable requirements of the Mississippi Department of Environmental Quality and/or the Mississippi Department of Health regulations and state laws.

JAMES WELLS 0-586
Print Name of Water Well Contractor and License No.


James Wells
Signature of Water Well Contractor

RECEIVED
OCT 06 2006
BY: OLWR

E-44

If well telescopes please sketch below and show depths.

Ground Level

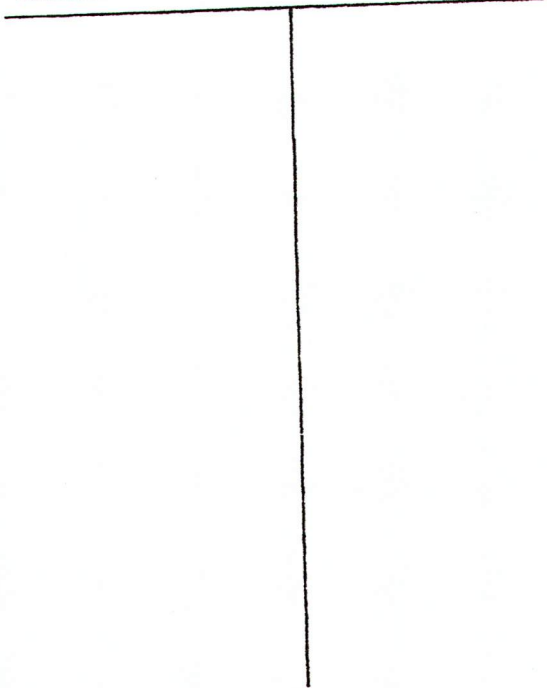

Description of Formations Encountered	From	To
7 1/2' Sand	0	2
clay	2	40
Sand	40	120
clay	120	140
Sand	140	228

If more than one screen, show location of each on sketch

Sketch the property layout and include the following: 1) the well location; 2) any permanent structures on the property that may aid in locating the well; 3) any roads, power lines, or other items that may aid in locating the property and the well; 4) indicate direction.

Landowner Name: Charles Gatt

James Wells
Signature of Water Well Contractor

RECEIVED
OCT 06 2006
BY: OLWR

STATE WELL REPORT

Part 2

Pump Installer's Completion Report
 Mississippi Department of Environmental Quality
 Office of Land and Water Resources
 P.O. Box 10631
 Jackson, MS 39289-0631
 (601)961-5210
 (601)354-6938 (fax)

For Office Use Only:

Aquifer: _____
 Well #: E-44
 Elevation: _____

County: Lawrence
 Permit #: _____
 Driller: JAMES WELLS
 Date completed: 9-15-06

This report should be prepared by the pump installer in detail and filed with the Department within 30 days of the installation of pump.

Well Owner Information	Well Location
Owner Name: <u>Charles Gatt</u>	Latitude: _____ Longitude: _____
Mailing Address: <u>P.O. Box 289</u> <u>New Helton, MS 39140</u>	Method of Lat/Long (circle one): Conventional Survey, USGS quad, Hand-held GPS, Survey-grade GPS
City _____ State _____ Zip Code _____	<u>1/4</u> _____ <u>1/4</u> Sec <u>4</u> Twp <u>20N</u> Rng <u>8W</u> <u>8N</u> <u>20W</u>
Telephone No. <u>(601) 886-7817</u>	Distance _____ Direction _____ Nearest Town _____ <u>5</u> Miles <u>SW</u> of <u>New Helton</u>

Pump Type Circle one	Power Type Circle one
Air Lift _____ Jet _____ <u>Submersible</u>	Diesel Engine _____ Gasoline Engine _____ Natural Gas _____
Bucket _____ Piston _____ Turbine _____	<u>Electric Motor</u> _____ Hand _____ Tractor PTO _____
Centrifugal _____ Rotary _____ Flowing Well _____	Windmill _____ Other (specify): _____
Other (specify): _____	Horse Power Rating of Motor: <u>1 1/2</u>
Date Pump Installed: <u>9-15-06</u>	Setting Depth: <u>180</u> feet
Rated Pump Capacity: <u>20</u> 100 Gallons Per Minute	Number of Stages: <u>11</u>

Pump Test Data	Method of Measuring Water Level Circle one
Date Well Tested: <u>9-15-06</u>	Air Line _____ Electric Measuring Line _____ <u>Steel Tape</u>
Static Water Level (A): <u>150</u> Feet Below Land Surface	Other (specify): _____
Pumping Water Level (B): <u>180</u> Feet Below Land Surface	For flowing well, measured shut in head: _____ feet
Drawdown [(B) - (A)]: <u>150</u> Feet Below Land Surface	Well yielded <u>20</u> GPM with a drawdown of
Test Pumping Rate: <u>20</u> Gallons Per Minute	<u>150</u> feet after <u>4</u> hours of pumping
Duration of Pump Test (minimum 4 hours): <u>4</u> hours	

I HEREBY CERTIFY that the above statements are true to the best of my knowledge.

JAMES WELLS 0-586
 Print Name of Pump Installer and License No. (if applicable)

James Wells
 Signature of Pump Installer

RECEIVED
 OCT 06 2006
 BY: OLWR