

LAWRENCE
F
5-12-78

MISSISSIPPI  
 BOARD OF WATER COMMISSIONERS  
 416 North State Street  
 Jackson, Mississippi 39201

WATER WELL DRILLERS LOG

May 12 19  
 date well completed

TOM GRIFFITH  
 PLUMBING & FURNACE SERVICE, INC.

Lawrence  
 county well located

LANDOWNER:  
 Billie Newsome  
 Monticello, Miss -  
 (mailing address)

description of formations encountered	from	to
	top soil	0
clay	2	45
clay	45	60
sand & gravel	60	100

WELL LOCATION:  
 sec. 30 T. 70 N. R. 100 W.  
 7 miles W of Monticello  
 (distance) (direction) (nearest town)

WELL PURPOSE: Home  
 (home, irrigation, municipal, industrial)

- WELL COMPLETION DATA:
- (1) diameter (inches) 4"
  - (2) total depth (feet) 100 ft
  - (3) static water level (feet) 29 ft below top of ground
  - (4) casing (material) plastic (depth) 80 ft  
 4" (size) If telescope see back.
  - (5) screen (length) 20 ft (depth to top) 80 ft  
 4" (size) plastic (material)
  - (6) pump (HP) 1/2 (yield gpm) 10  
 Electric (type power)
  - (7) electric log no (yes or no)
  - (8) how well bottom plugged BWV

(Lafayette - Lavndes)

D Logs in alph. order

(Have been copied!)

RECEIVED


JUN 30 1978

MISS. BD. OF WATER COMM

DRILLERS REMARKS:

If well telescopes please sketch and show depths.

GROUND LEVEL

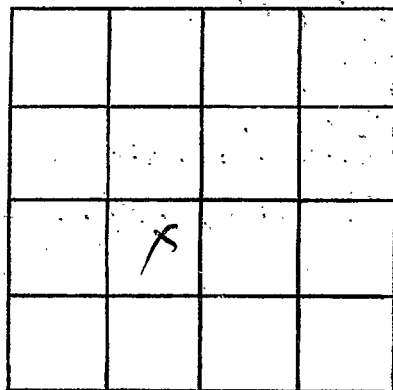

SECTION 30

Please indicate well location X.

ADDITIONAL INFORMATION

If more than one screen, show locations of each on sketch.