

LAWR.

F5

3-11-63

WATER WELL DRILLERS LOG

CODED *OK 922*

Date: March 11 1963, Driller: Roy Chandler Jr. County: LAWRENCE
 (Name)

(1) Owner of Land: J.G. RUSSELL
 (Name)

RFD MONTICELLO 10-7106
 (Address)

(2) Location: 5 1/2 MI-NORTH ON NOLA
 1/4, 1/4, Sec. T. R.

MONTICELLO-ROAD-
 miles of
 (distance) (direction) (Nearest Town)

(3) Topography: WELL ON MEDIUM HILL
 (Hilly) (Flat) (Level)

(4) Purpose of Well: HOME
 (Domestic Irrigation
 Municipal, Industrial, Other)

Description & Color of Materials Sand, Clay, Red Clay, Shell, etc.	Thick- ness Feet	Depth Feet
BLACK TOP SOIL	4	4
WHITE SAND	20	20
BORED THRU OLD ROTTEN LOG ABOUT 26' DOWN		
BROWN SAND & CLAY	10	10
BALANCE OF HOLE GREENISH PIPE CLAY	76	76

Information upon completion of well:

(1) Diameter 30 inches.

(2) Total Depth 60 feet.

(3) Water Level 30 feet below top of ground.

(4) Cased to 60', Size 15"


(5) Screen: Size NONE, Length —

(6) Were any formations sealed against pollution?
WELL TO BE SEALED

4' yes no.
 If YES depth of formation WITH CONCRETE

Why KEEP OUT RAIN WATER

Drillers Remarks: USED TWO LARGE
 STEEL CAISSONS TO SEAL
 OFF WATER & SAND WHILE
 DRILLING - TILES WERE

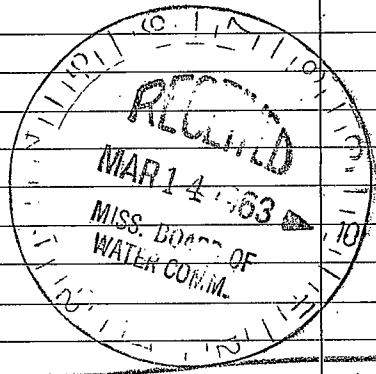

SET INDIVIDUALLY
 WITH A TILE SETTER.
 THEN STEEL CAISSONS
 WERE PULLED OUT OF
 HOLE - WITH WASHED
 GRAVEL PUT AROUND
 TILES & THE HOLE

(Use Back Side)

Well No.