

Lawrence
77
2-28-69

MISSISSIPPI
BOARD OF WATER COMMISSIONERS
416 North State Street
Jackson, Mississippi 39201

WATER WELL DRILLERS LOG

Feb-28-69 date well completed
Kerner well Drilling Lawrence firm name
Lawrence county well located

LANDOWNER: Raymond Olive
Mantuelle (mailing address)

description of formations encountered	from	to
clay	0	8
red sand	8	15
red white chalk	15	37
Sand & gravel	37	85
Coarse sand	85	95

WELL LOCATION:
sec. 21 T. 7 N R. 10 E
5 miles (distance) E Mantuelle (direction) (nearest town)

WELL PURPOSE: Home (home, irrigation, municipal, industrial)

WELL COMPLETION DATA:

- (1) diameter (inches) 4"
- (2) total depth (feet) 95
- (3) static water level (feet) _____ below above top of ground
- (4) casing Plastic bottom (material) (depth)
- (5) screen 6' 89' (length) (depth to top)
4" Plastic (size) (material)
- (6) pump 1/2 HP Sub-12 (HP) (yield gpm)
Elect (type power)
- (7) electric log NO (yes or no)
- (organization running log)

(8) how well bottom plugged
wooden plug

DRILLERS REMARKS:
New location


APR 9 1969

MISS. BD. OF
WATER COMMISSIONERS

MISS. BD. OF
WATER COMMISSIONERS

If well telescopes please sketch and show depths.

GROUND LEVEL

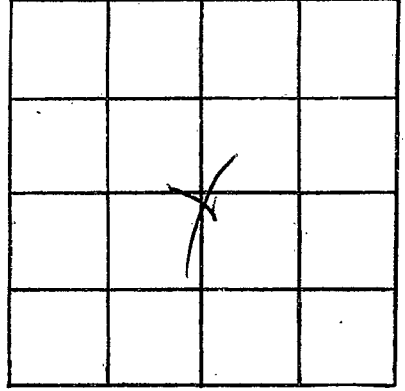

SECTION 2-1

Please indicate well location X.

ADDITIONAL INFORMATION

If more than one screen, show locations of each on sketch.