

Lawrence

F B

11-66 MISSISSIPPI BOARD OF WATER COMMISSIONERS

CODED

WATER WELL DRILLERS LOG

Date: 11/12, 1966, Driller: T. B. Andrews County LAWRENCE
(When well drilled) (Name) (Where well is located)

(1) Owner of Land: Edgar Smith
(Name)
Rt. 1 Monticello, Miss.
(Address)

Description & Color of Materials Sand, Clay, Red Clay, Shell, etc.	Thick- ness Feet	Depth Feet
<u>Red Clay</u>	<u>40'</u>	<u>40'</u>
<u>gray clay</u>	<u>40'</u>	<u>80'</u>
<u>Sand</u>	<u>18'</u>	<u>98'</u>

(2) Location: NW 1/4, NW 1/4, Sec. 21 T7 R10 E
7 miles N.W. of Monticello
(distance) (direction) (Nearest Town)

(3) Topography: Hilly
(Hilly) (Flat) (Level)

(4) Purpose of Well: Domestic
(Domestic Irrigation
Municipal, Industrial, Other)

Information upon completion of well:

(1) Diameter 2" inches.

(2) Total Depth 98 feet.

(3) Water Level 80 feet below top of ground.

(4) Cased to 98', Size 2"

(5) Screen: Size 2", Length 5'

(6) Were any formations sealed against pollution?
no.

If YES depth of formation _____


Why _____

Drillers Remarks: _____

Yield in gpm: 4

Size pump: 3/4 h.p.

Type power: 110 Elec.

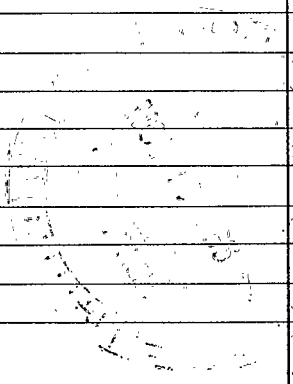

48

