

CODED

MISSISSIPPI  
BOARD OF WATER COMMISSIONERS  
416 North State Street  
Jackson, Mississippi 39201

WATER WELL DRILLERS LOG

LAWRENCE  
F 9  
8-9-69

Aug 9 69 Keene Well Drilling Lawrence county well located

LANDOWNER: Shelton Smith  
PE-1, Monticello  
(mailing address)

WELL LOCATION:  
sec 20 T 7 N R 10 E  
6 1/2 miles W Monticello  
(distance) (direction) (nearest town)

WELL PURPOSE: Home  
(home, irrigation, municipal, industrial)

- WELL COMPLETION DATA:
- (1) diameter (inches) 4"
  - (2) total depth (feet) 147
  - (3) static water level (feet) 121 below top of ground.
  - (4) casing Plastic Bellows  
(material) (depth)
  - (5) screen 6' (length) 14' (depth to top)  
4" (size) Plastic (material)
  - (6) pump 3/4 Sub (HP) 12 (yield gpm)  
Sleek (type power)
  - (7) electric log no (yes or no)
- (organization running log)

description of formations encountered	from	to
Red sandy clay	0	27
Red sand	27	71
Small gravel	71	77
white chalk	77	101
Red gravel & sand	101	131
Red chalk	131	136
Coarse sand & gravel	136	147


(8) how well bottom plugged wood plug

DRILLERS REMARKS: old 2" well bad

SEP 23 1969  
MISS. BUREAU OF WATER

If well telescopes please sketch and show depths.

GROUND LEVEL

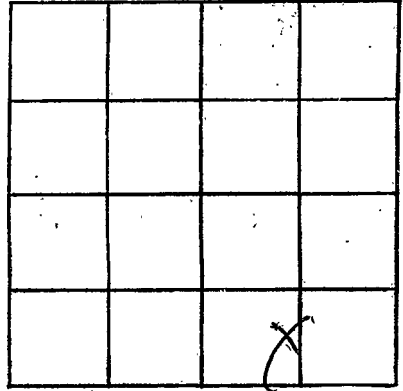

SECTION 20

Please indicate well location X.

ADDITIONAL INFORMATION

If more than one screen,  
show locations of each on sketch.