

MISSISSIPPI
 BOARD OF WATER COMMISSIONERS
 416 North State Street
 Jackson, Mississippi 39201

CODED

WATER WELL DRILLERS LOG

LAWRENCE
F10
11-5-70

Nov. 5 1970 Grenn Water Well Cont. Lawrence
 date well completed firm name county well located

| LANDOWNER: | description of formations encountered | from | to |
|---|---------------------------------------|--------|----------|
| Lavina Brown Rt. 1, Monticello, Miss. (mailing address) | Citronelle Catahoula | 0 6 | 5 160 |
| WELL LOCATION: sec. <u>2</u> T. <u>7</u> <u>N</u> R. <u>10</u> <u>E</u> <u>5</u> miles <u>NW</u> of <u>Monticello</u> (distance) (direction) (nearest town) | | | |
| WELL PURPOSE: <u>home</u> (home, irrigation, municipal, industrial) | | | |
| WELL COMPLETION DATA: | | | |
| (1) diameter (inches) <u>6</u> | | | |
| (2) total depth (feet) <u>160</u> | | | |
| (3) static water level (feet) <u>35</u> <u>below</u> <u>above</u> top of ground. | | | |
| (4) casing <u>PVC</u> <u>147</u> (material) (depth) <u>4"</u> (size) if telescope see back. | | | |
| (5) screen <u>4'</u> <u>147</u> (length) (depth to top) <u>.010</u> <u>PVC</u> (size) (material) | | | |
| (6) pump <u>did not install</u> (HP) (yield gpm) (type power) | | | |
| (7) electric log <u>no</u> (yes or no) (organization running log) | | | |
| (8) how well bottom plugged <u>wood</u> | | | |
| DRILLERS REMARKS: | | | |


CODED

NOV 23 1970

MISS. BD. OF
 WATER COMMISSIONERS

If well telescopes please sketch and show depths.

GROUND LEVEL

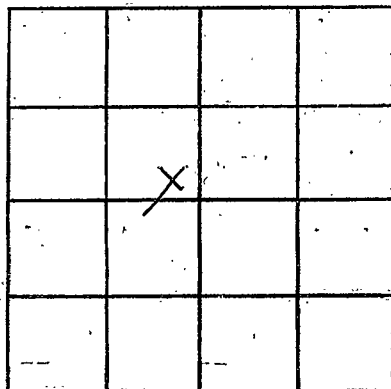

SECTION 2

Please indicate well location X.

ADDITIONAL INFORMATION

If more than one screen, show locations of each on sketch.