

LAWRENCE
 F 11
 11-6-70

MISSISSIPPI
 BOARD OF WATER COMMISSIONERS
 416 North State Street
 Jackson, Mississippi 39201

CODED

WATER WELL DRILLERS LOG

Nov. 6 1970 Grenn Water Well Cont. Lawrence
 date well completed firm name county well located

LANDOWNER:	description of formations encountered	from	to
Pateo Enterprises			
Monticello	Catahoula	7	120
(mailing address)			
WELL LOCATION:			
sec. 2 T. 7 S. R. 10 E			
5 1/4 miles NW of Monticello			
(distance) (direction) (nearest town)			
WELL PURPOSE: home			
(home, irrigation, municipal, industrial)			
WELL COMPLETION DATA:			
(1) diameter (inches) 6			
(2) total depth (feet) 120			
(3) static water level (feet) 30 below top of ground.			
(4) casing PVC 110			
(material) (depth)			
(size) if telescope see back.			
(5) screen 4' 110			
(length) (depth to top)			
.010 PVC			
(size) (material)			
(6) pump did not install			
(HP) (yield gpm)			
(type power)			
(7) electric log no			
(yes or no)			
(organization running log)			
(8) how well bottom plugged wood			
DRILLERS REMARKS:			


CODED

NOV 23 1970

MISS. Bd. of WATER Comm.

If well telescopes please sketch and show depths.

GROUND LEVEL

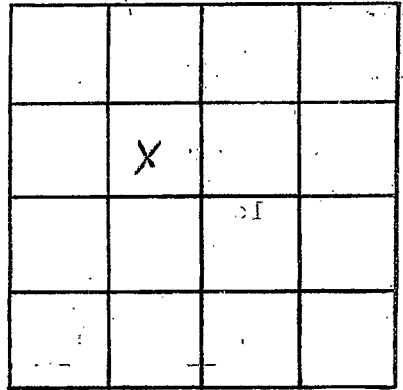

SECTION 2

Please indicate well location X.

ADDITIONAL INFORMATION

If more than one screen, show locations of each on sketch.