

CODED

LAWRENCE

F-12

7-6-71

MISSISSIPPI BOARD OF WATER COMMISSIONERS 416 North State Street Jackson, Mississippi 39201

CODED

WATER WELL DRILLERS LOG

July 6 1971 Green Weaver Well Contractor Lawrence date well completed firm name county well located

LANDOWNER: O. L. Russell

R. t 1, Box 112

Monticello, Miss. 39654

(mailing address)

description of formations encountered

from to Citronelle 0 200

WELL LOCATION:

sec 32 T 7 N R 10 E 7 miles West of Monticello (distance) (direction) (nearest town)

WELL PURPOSE: home (home, irrigation, municipal, industrial)

WELL COMPLETION DATA:

- (1) diameter (inches) 6"
(2) total depth (feet) 220
(3) static water level (feet) 100 below top of ground
(4) casing PVC 194 (material) (depth) 2" (size) if telescope see back.
(5) screen 6' 194 (length) (depth to top) .010 PVC (size) (material)
(6) pump did not install (HP) (yield gpm)
(7) electric log no (yes or no)
(8) how well bottom plugged wood

CODED


AUG 17 1971

DRILLERS REMARKS:

MISS. Bd. of Water Comm. Jackson, Miss.

If well telescopes please sketch and show depths.

GROUND LEVEL

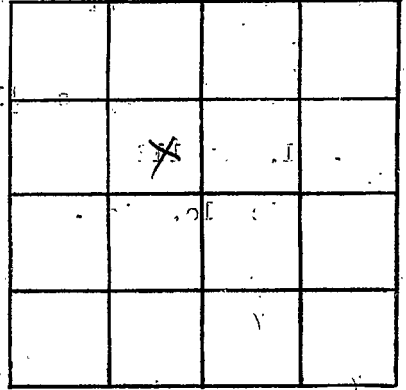

SECTION 32

Please indicate well location X.

ADDITIONAL INFORMATION

Lined area for additional information.

If more than one screen, show locations of each on sketch.