

LAWRENCE

F15

2-75

E Log # 35

MISSISSIPPI BOARD OF WATER COMMISSIONERS
416 North State Street
Jackson, Mississippi 39201

CODED

WATER WELL DRILLERS LOG

Feb 1 1975 Griner Drilling Service Lawrence
date well completed firm name county well located

LANDOWNER: LAWRENCE
COUNTY WATER ASSOC.
Well No. 3
(mailing address)

WELL LOCATION: N 1/4 N 1/4
sec. 27 T 7 N R 10 E 13 W
5 miles W of Monticello
(distance) (direction) (nearest town)

WELL PURPOSE:
(home, irrigation, municipal, industrial)

- WELL COMPLETION DATA:
- (1) diameter (inches) 8 5/8"
 - (2) total depth (feet) 834 ft.
 - (3) static water level (feet) 119 below above top of ground.
 - (4) casing B.I. 792'
(material) (depth)
8 5/8" if telescope see back.
(size)
 - (5) screen 40 ft. 794'
(length) (depth to top)
6" 304 S.S. (.008)
(size) (material)
 - (6) pump 30 162
(HP) (yield gpm)
Elect.
(type power)
 - (7) electric log Yes
(yes or no)
N.S.G.S.
(organization running log)
 - (8) how well bottom plugged BACK
WASH W/ WTE

description of formations encountered	from	to
Red SAND + Clay	0	5
SAND + Gravel	5	64
CLAY	64	88
SAND	88	131
CLAY	131	404
SAND w/clay streaks	404	577
Clay	577	788
SAND	788	836
SANDY CLAY	836	850
SAND	850	875
CLAY	875	904

CODED

DISCONTINUED INVESTIGATION

NOV 12 1975

MISS. BO. OF


JMM

DRILLERS REMARKS:

8

If well telescopes please
sketch and show depths.

GROUND LEVEL

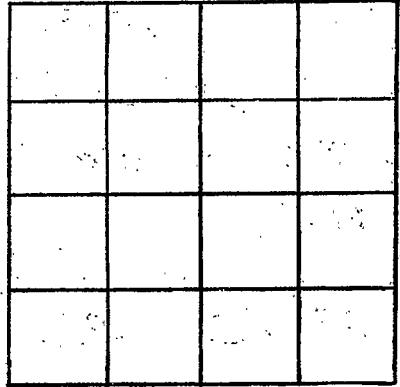

SECTION _____

Please indicate well location X.

ADDITIONAL INFORMATION

If more than one screen,
show locations of each on sketch.