

Lawrence
 F 2000
 10-10-75

MISSISSIPPI
 BOARD OF WATER COMMISSIONERS
 416 North State Street
 Jackson, Mississippi 39201

WATERWELL DRILLERS LOG


10-10
 date well completed

13V 75 ~~Garner~~ - Ginn Lawrence
 firm name county well located

LANDOWNER:	description of formations encountered	from	to
M. C. Collins	Top Soil	0	1
Pt 1, Monticello (mailing address)	Clay SAND	1	44
WELL LOCATION:	SAND	44	50
sec. <u>1</u> T <u>7</u> N R <u>10</u> E <u>7</u> miles <u>NW</u> of <u>Monticello</u> (distance) (direction) (nearest town)	Chalk	50	206
WELL PURPOSE: <u>Home</u> (home, irrigation, municipal, industrial)	Shale	206	310
WELL COMPLETION DATA:	SAND	210	340
(1) diameter (inches) <u>2</u>			
(2) total depth (feet) <u>330</u> 340			
(3) static water level (feet) <u>70</u> below top of ground.			
(4) casing <u>PVC</u> <u>330</u> (material) (depth) <u>2</u> if telescope see back. (size)			
(5) screen <u>10 1/2</u> <u>330 ft</u> (length) (depth to top)			
(6) pump <u>1</u> <u>7</u> (HP) (yield gpm)			
(7) electric log <u>No.</u> (yes or no) <u>Elec.</u> (type power)			
(8) how well bottom plugged <u>BW Valve</u> (organization running log)			
DRILLERS REMARKS:			

If well telescopes please sketch and show depths.

GROUND LEVEL

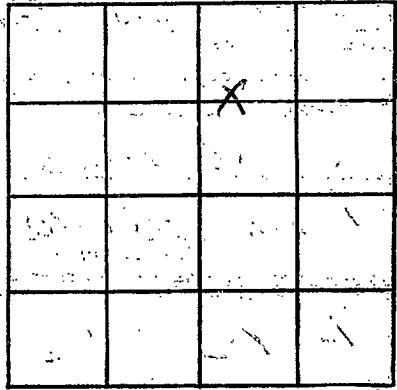

SECTION /

Please indicate well location X.

ADDITIONAL INFORMATION

If more than one screen, show locations of each on sketch.