

LAWRENCE
 F 2001
 6-27-77

MISSISSIPPI
 BOARD OF WATER COMMISSIONERS
 416 North State Street
 Jackson, Mississippi 39201

WATER WELL DRILLERS LOG

6-27 1977 Ginn Well Serv. Lawrence
 date well completed firm name county well located

LANDOWNER:
Mr. Paul Pittman
Rt. 1 Monticello, Miss.
 (mailing address)

description of formations encountered	from	to
Top Soil	0	1
Clay - Red	1	31
Clay + gravel	31	54
Chalk	54	300
SAND	300	348

WELL LOCATION:
 sec. 12 T. 07 N R. 10 E
3 1/2 miles NW of Monticello
 (distance) (direction) (nearest town)

WELL PURPOSE: Home
 (home, irrigation, municipal, industrial)

- WELL COMPLETION DATA:
- (1) diameter (inches) 4"
 - (2) total depth (feet) 345 ft
 - (3) static water level (feet) 100 below top of ground.
 - (4) casing Plastic 320'
 (material) (depth)
4" if telescope see back.
 (size)
 - (5) screen 70 ft 325'
 (length) (depth to top)
4" Plastic
 (size) (material)
 - (6) pump 3/4 10
 (HP) (yield gpm)
Elec
 (type power)
 - (7) electric log No
 (yes or no)

RECEIVED
 OCT 25 1977


(organization running log)
 (8) how well bottom plugged B. W. Valve

DRILLERS REMARKS:

MISS. BD. OF WATER COMM.

If well telescopes please sketch and show depths.

GROUND LEVEL

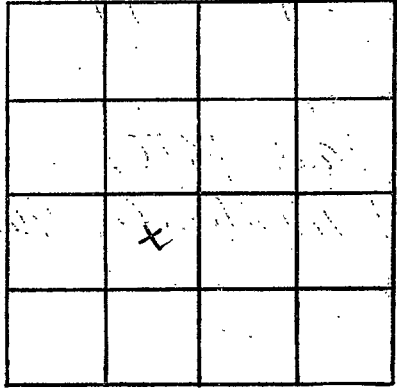

SECTION 12

Please indicate well location X.

ADDITIONAL INFORMATION

Multiple horizontal lines for writing additional information.

If more than one screen, show locations of each on sketch.