

LAWRENCE
F 2003

MISSISSIPPI
BOARD OF WATER COMMISSIONERS
416 North State Street
Jackson, Mississippi 39201

11

2-15-80

WATER WELL DRILLERS LOG

Lawrence
F 2003

2-15
date well completed

19 80
firm name O Ser.

county well located

LANDOWNER: <u>Eare Russell</u> <u>Rt. 4 Box 93</u> <u>Columbia Ms.</u> (mailing address)	description of formations encountered	from	to
	<u>CHALK gravel</u>	<u>0</u>	<u>30</u>
	<u>CHALK</u>	<u>30</u>	<u>200</u>
	<u>sand</u>	<u>200</u>	<u>230</u>
WELL LOCATION:			
sec <u>36 T 7 N</u> R <u>10 E</u>			
<u>5</u> miles <u>W</u> of <u>Monticello</u>			
WELL PURPOSE: <u>house</u> (home, irrigation, municipal, industrial)			
WELL COMPLETION DATA:			
(1) diameter (inches) <u>4"</u>			
(2) total depth (feet) <u>230</u>			
(3) static water level (feet) <u>40</u> ^{below} above top of ground.			
(4) casing <u>PVC</u> <u>220</u> (material) (depth)			
_____ (size) if telescope see back.			
(5) screen <u>10 ft</u> <u>220</u> (length) (depth to top)			
<u>4"</u> <u>PVC</u> (size) (material)			
(6) pump <u>1/2</u> <u>15</u> (HP) (yield gpm)			
<u>electric</u> (type power)			
(7) electric log _____ (yes or no)			
_____ (organization running log)			
(8) how well bottom plugged <u>sand</u> <u>stark</u>			
DRILLERS REMARKS: <u>good</u> <u>00000</u>			


DEPT. OF NATURAL RESOURCES
BUREAU OF LAND & WATER RESOURCES

APR 14 1980

RECEIVED

If well telescopes please sketch and show depths.

GROUND LEVEL

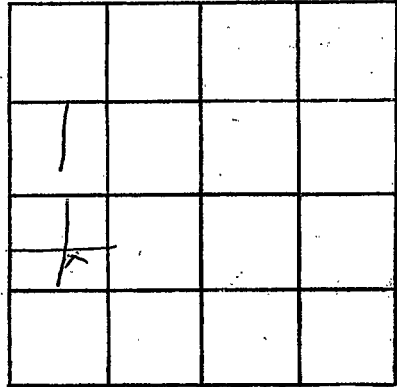

SECTION 36

Please indicate well location X.

ADDITIONAL INFORMATION

If more than one screen,
show locations of each on sketch.