

Lawrence
F 2004
6-12-81

MISSISSIPPI DEPARTMENT OF NATURAL RESOURCES
 Bureau of Land and Water Resources
 Southport Mall
 P.O. Box 10631
 Jackson, Mississippi 39209
WATER WELL DRILLERS LOG


June 12, 1981 Grenn Water Well Cont. Lawrence
 date well completed firm name county well located

LANDOWNER:	description of fomations encountered	from	to
<u>Thomas P. Russell</u> II			
<u>Route 1, Box 188</u>	<u>sand & gravel</u>	<u>1</u>	<u>10</u>
<u>Monticello, Ms.</u>	<u>white clay</u>	<u>10</u>	<u>85</u>
<u>(mailing address)</u>	<u>sand</u>	<u>85</u>	<u>142</u>
WELL LOCATION:			
sec <u>31</u> T <u>7</u> N <u>10</u> E S W			
<u>8</u> miles <u>W</u> of <u>Monticello</u> (distance) (direction) (nearest town)			
WELL PURPOSE: <u>home</u> (home, irrigation, municipal, industrial)			
WELL COMPLETION DATA:			
(1) diameter (inches) <u>4</u>			
(2) total depth (feet) <u>142</u>			
(3) static water level (feet) <u>80</u> <u>below</u> above top of ground.			
(4) casing <u>PVC</u> , <u>132</u> (material) (depth) <u>4"</u> (size) if telescope see back.			
(5) screen <u>10'</u> , <u>132'</u> (length) (depth to top) <u>.010</u> , <u>PVC</u> (size) (material)			
(6) pump <u>1/2 sub</u> , <u>8</u> (HP) (yield gpm) <u>electricity</u> (type power)			
(7) electric log <u>no</u> (yes or no) <u>(organization running log)</u>			
(8) how well bottom plugged <u>back wash valve</u>			
DRILLERS REMARKS:			



If well telescopes please sketch and show depths.

GROUND LEVEL

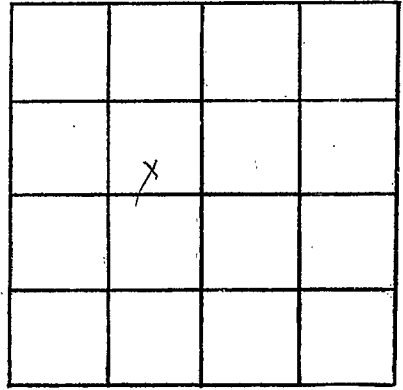

SECTION 31

Please indicate well location X.

ADDITIONAL INFORMATION

If more than one screen, show locations of each on sketch.