

MISSISSIPPI DEPARTMENT OF NATURAL RESOURCES

Bureau of Land and Water Resources

Southport Mall

P.O. Box 10631

Jackson, Mississippi 39209

WATER WELL DRILLERS LOG

Lawrence
F
2006

May 18 1983 Grem Water Well Lawrence
date well completed firm name county well located

LANDOWNER: Wayne Smith
Rt. 1, Box 183 BB
Monticello, Ms.
(mailing address)

description of formations encountered	from	to
Citronelle	1	105

WELL LOCATION:
sec 21 T 7 N R 10 E
S W
5 miles W of Monticello
(distance) (direction) (nearest town)

WELL PURPOSE: none
(home, irrigation, municipal, industrial)

WELL COMPLETION DATA:

- (1) diameter (inches) 4
- (2) total depth (feet) 105
- (3) static water level (feet) 60 below above top of ground.
- (4) casing PVC 85'
(material) (depth)
4" (size) If telescope see back.
- (5) screen 20' 85'
(length) (depth to top)
.010 PVC
(size) (material)
- (6) pump 1 sub. 8
(HP) (yield gpm)
- electricity
(type power)
- (7) electric log no
(yes or no)
- (organization running log)

(8) how well bottom plugged back wash valve

DRILLERS REMARKS:


DEPT. OF NATURAL RESOURCES
BUREAU OF LAND & WATER RESOURCES

AUG 30 1983

RECEIVED

If well telescopes please sketch and show depths.

GROUND LEVEL

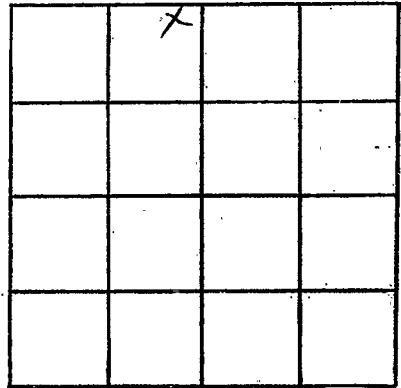

SECTION 21

Please indicate well location X.

ADDITIONAL INFORMATION

If more than one screen,
show locations of each on sketch.