

MISSISSIPPI DEPARTMENT OF NATURAL RESOURCES
Bureau of Land and Water Resources
 Southport Mall
 P.O. Box 10631
 Jackson, Mississippi 39209
WATER WELL DRILLERS LOG

F2007
LAURENCE
3-22-85

3-22 1985 Hollinger Lawrence
 date well completed firm name county well located

LANDOWNER:
Harold HARRIS HARRIS
Jayess, Inc
 (mailing address)

description of formations encountered	from	to
	<u>Red clay gravel</u>	<u>0</u>
<u>coarse sand</u>	<u>60</u>	<u>87</u>

WELL LOCATION:
 sec. 5 T. 7N R. 10E
8 miles S of Monticello
 (distance) (direction) (nearest town)

WELL PURPOSE:
 (home, irrigation, municipal, industrial)

WELL COMPLETION DATA:

(1) diameter (inches) 4"

(2) total depth (feet) 87

(3) static water level (feet) 50 below above top of ground.

(4) casing PVC 77
 (material) (depth)
 (size) if telescope see back.

(5) screen 10 77
 (length) (depth to top)
4 PVC
 (size) (material)

(6) pump 1 20
 (HP) (yield gpm)
dent
 (type power)

(7) electric log (yes or no)

(organization running log)

(8) how well bottom plugged Good
SHANK


DRILLERS REMARKS: good well

RECEIVED
 APR 4 - 1985

Department of Natural Resources
 Bureau of Land & Water Resources

If well telescopes please sketch and show depths.

GROUND LEVEL

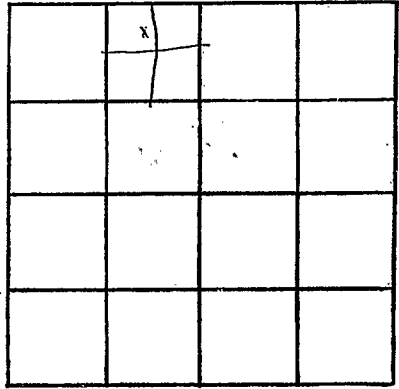

SECTION 5

Please indicate well location X.

ADDITIONAL INFORMATION

If more than one screen, show locations of each on sketch.