

TYPE II WELL CONSTRUCTION LOG

PROJECT NAME: 84 Food Mart WELL RW1

TOWN/CITY Montzello

COUNTY Lawrence STATE MS

PERMIT NO. _____

LAND SURFACE ELEVATION AND DATUM _____ NGVD FEET SURVEYED ESTIMATED

INSTALLATION DATE(S) 4-9/11-01

DRILLING METHOD Hollow Stem Auger

DRILLING CONTRACTOR _____

DRILLING FLUID _____

DEVELOPMENT TECHNIQUE(S) AND DATE(S) _____

FLUID LOSS DURING DRILLING _____ GALLONS

WATER REMOVED DURING DEVELOPMENT _____ GALLONS

STATIC WATER DEPTH _____ FEET BELOW MFL

YIELD _____ GALLONS/MINUTE (GPM)

SPECIFIC CAPACITY _____ GPM/FT


WELL PURPOSE Recovery Well

REMARKS _____

PREPARED BY: _____

RECEIVED
JUN 05 2001

Dept. of Environmental Quality
Office of Land & Water Resources

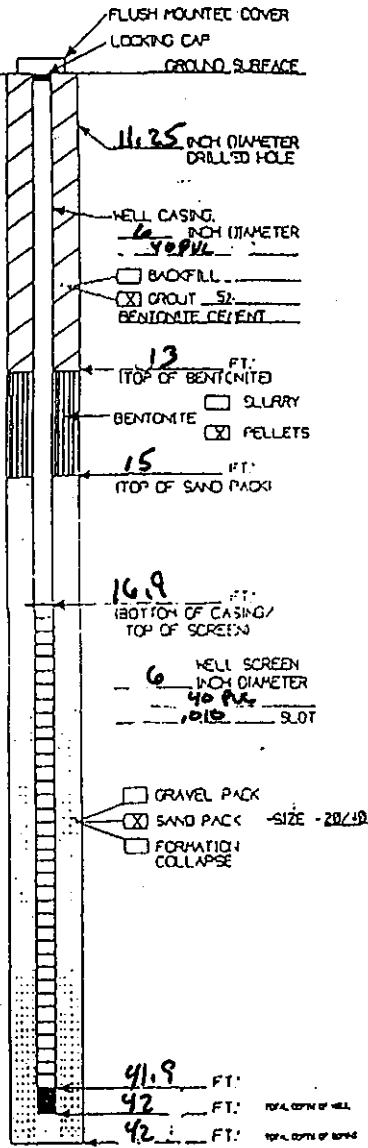

NOTE: ALL DEPTHS MEASURED RELATIVE TO GROUND SURFACE
NH - NOT MEASURED