

TYPE II WELL CONSTRUCTION LOG

PROJECT NAME: 84 Food Mart Well RW 3

TOWN/CITY: Meridale

COUNTY: Lewis STATE: MS

PERMIT NO. _____

LAND SURFACE ELEVATION AND DATUM _____ NGVD FEET SURVEYED ESTIMATED

INSTALLATION DATE(S): 4-9-01

DRILLING METHOD: Rotary Drilling

DRILLING CONTRACTOR: _____

DRILLING FLUID: _____

DEVELOPMENT TECHNIQUE(S) AND DATE(S): _____

FLUID LOSS DURING DRILLING _____ GALLONS

WATER REMOVED DURING DEVELOPMENT _____ GALLONS

STATIC WATER DEPTH _____ FEET BELOW MP

YIELD _____ GALLONS/MINUTE (GPM)

SPECIFIC CAPACITY _____ GPM/FT


WELL PURPOSE: Recovery Well

REMARKS: _____

PREPARED BY: _____

RECEIVED
JUN 05 2001

Dept. of Environmental Quality
Office of Land & Water Resources

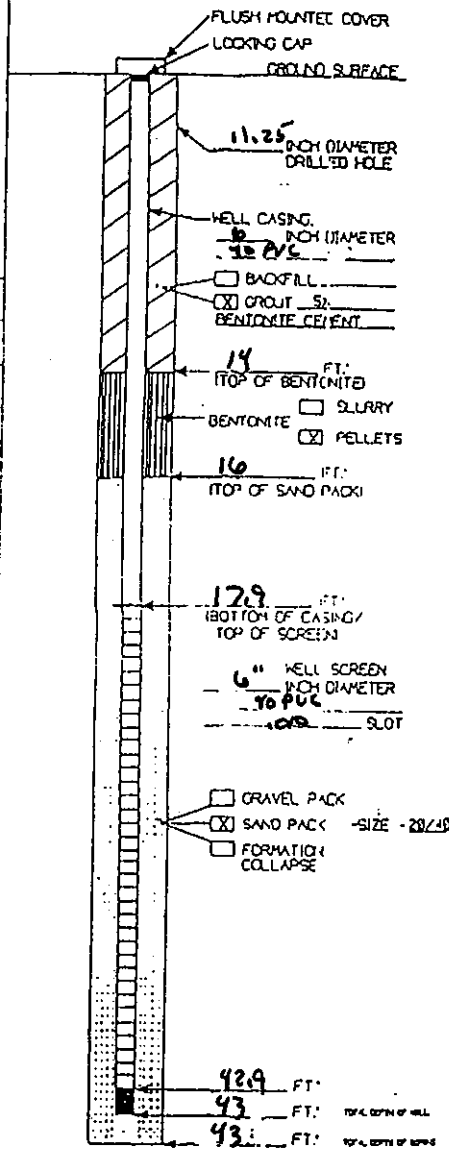

NOTE: ALL DEPTHS MEASURED RELATIVE TO GROUND SURFACE. NM - NOT MEASURED