

TYPE II WELL CONSTRUCTION LOG

PROJECT NAME: 84 Food Mart WELL AW3

TOWN/CITY Mumbelle

COUNTY Louisiana STATE MS

PERMIT NO. _____

LAND SURFACE ELEVATION AND DATUM _____ SURVEYED
NGVD FEET

ESTIMATED

INSTALLATION DATE(S) 4-9/14-01

DRILLING METHOD Hollow Stem Auger

DRILLING CONTRACTOR _____

DRILLING FLUID _____

DEVELOPMENT TECHNIQUE(S) AND DATE(S) _____

FLUID LOSS DURING DRILLING _____ GALLONS

WATER REMOVED DURING DEVELOPMENT _____ GALLONS

STATIC WATER DEPTH _____ FEET BELOW M?

YIELD _____ GALLONS/MINUTE (GPM)

SPECIFIC CAPACITY _____ GPM/FT


WELL PURPOSE Recovery Well

REMARKS _____

RECEIVED
JUN 05 2001

PREPARED BY: _____

Dept. of Environmental Quality
Office of Land & Water Resources

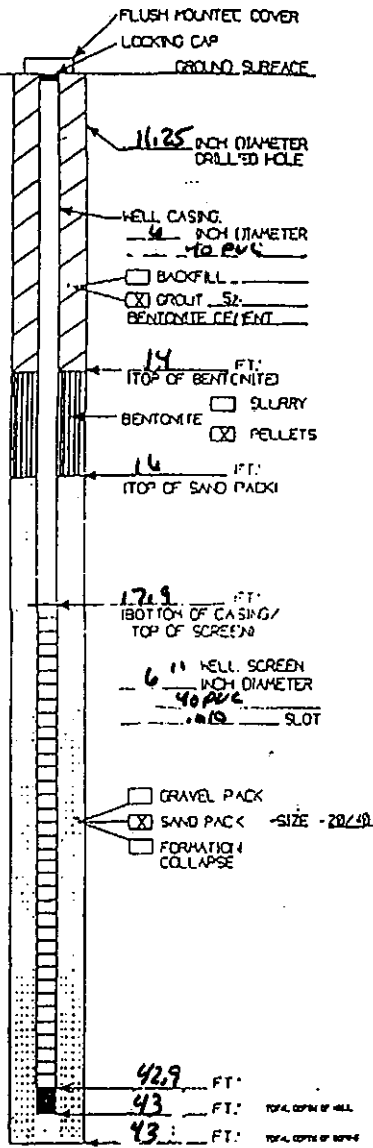

NOTE: ALL DEPTHS MEASURED RELATIVE TO GROUND SURFACE
NM - NOT MEASURED