

MISSISSIPPI BOARD OF WATER COMMISSIONERS

LAWR.
G5

WATER WELL DRILLERS LOG

ORDER **INDEXED**

9-7-62

Date: 9-7, 1962, Driller Chester Reeves Lawrence County Lawrence

(Name)

(1) Owner of Land	Description & Color of Materials Sand, Clay, Red Clay, Shell, etc.	Thick- ness Feet	Depth Feet
G.L. Carr (Name) AD 3, Monticello (Address) 27-7-17 27-7-17	yellow sandy clay	10	10
(2) Location: $\frac{1}{4}$, $\frac{1}{4}$, Sec. T R 2 miles north of Monticello (distance) (direction) (Nearest Town)	white sand & gravel blue chalk	15 145	25 190
(3) Topography: Flat (Hilly) (Flat) (Level)	fine white sand	40	230
(4) Purpose of Well: Domestic (Domestic Irrigation Municipal, Industrial, Other)	coarse clean sand	13	243


Information upon completion of well:

- (1) Diameter: 2 inches.
- (2) Total Depth: 243 feet.
- (3) Water Level: artesian feet below top of ground.
- (4) Cased to: Bottom Size: 9"
- (5) Screen: Size: 1/4" Length: 8'
- (6) Were any formations sealed against pollution?
 yes, no.

If YES depth of formation _____

Why _____

Drillers Remarks: old well stopped up.

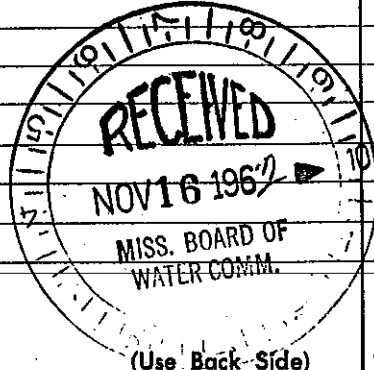

Well No. _____

Mail this copy to Board of Water Commissioners 429 Miss. St. Jackson, Miss