

# TYPE II WELL CONSTRUCTION LOG

PROJECT NAME: 84 Food Mart WELL MW11

TOWN/CITY Monticello

COUNTY Linn STATE MS

PERMIT NO. \_\_\_\_\_

LAND SURFACE ELEVATION AND DATUM \_\_\_\_\_ NGVD FEET  SURVEYED  
 ESTIMATED

INSTALLATION DATE(S) 4-9/11-01

DRILLING METHOD Hollow Stem Auger

DRILLING CONTRACTOR \_\_\_\_\_

DRILLING FLUID \_\_\_\_\_

DEVELOPMENT TECHNIQUE(S) AND DATE(S) \_\_\_\_\_

FLUID LOSS DURING DRILLING \_\_\_\_\_ GALLONS

WATER REMOVED DURING DEVELOPMENT \_\_\_\_\_ GALLONS

STATIC WATER DEPTH \_\_\_\_\_ FEET BELOW M.P.

YIELD \_\_\_\_\_ GALLONS/MINUTE (GPM)

SPECIFIC CAPACITY \_\_\_\_\_ GPM/FT


WELL PURPOSE monitoring well

REMARKS \_\_\_\_\_

**RECEIVED**  
 JUN 05 2001

Dept. of Environmental Quality  
 Office of Land & Water Resources

PREPARED BY: \_\_\_\_\_

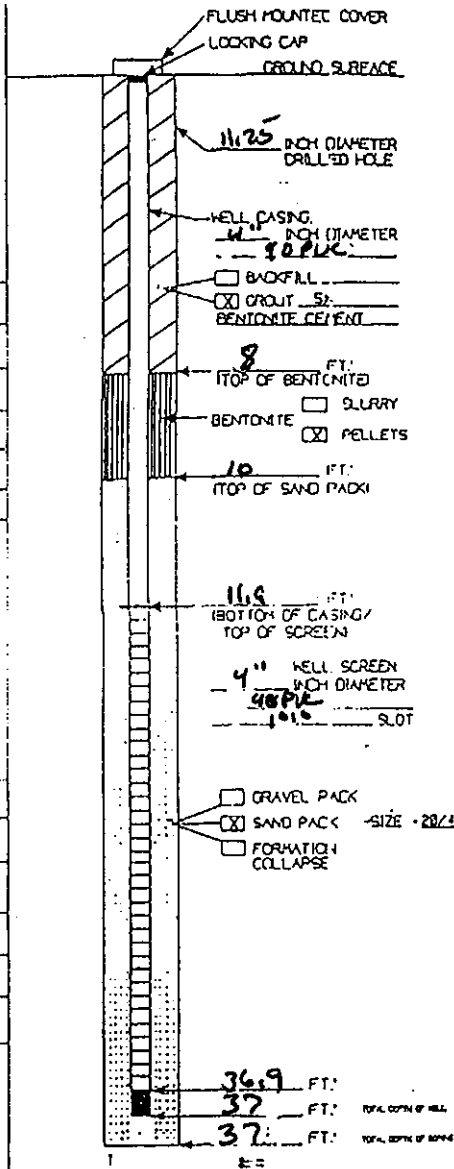

NOTE: ALL DEPTHS MEASURED RELATIVE TO GROUND SURFACE  
 NH - NOT MEASURED