

TYPE II WELL CONSTRUCTION LOG

PROJECT NAME: 84 Food Mart WELL mw 12

TOWN/CITY Monticello

COUNTY Lourence STATE MS

PERMIT NO. _____

LAND SURFACE ELEVATION AND DATUM _____ NGVD FEET SURVEYED
 ESTIMATED

INSTALLATION DATE(S) 4-9/11-01

DRILLING METHOD Ballou Star Auger

DRILLING CONTRACTOR _____

DRILLING FLUID _____

DEVELOPMENT TECHNIQUE(S) AND DATE(S) _____

FLUID LOSS DURING DRILLING _____ GALLONS

WATER REMOVED DURING DEVELOPMENT _____ GALLONS

STATIC WATER DEPTH _____ FEET BELOW M.P.

YIELD _____ GALLONS/MINUTE (GPM)


SPECIFIC CAPACITY _____ GPM/FT

WELL PURPOSE Monitoring well

REMARKS _____

RECEIVED
 JUN 05 2001

PREPARED BY: _____
 Dept. of Environmental Quality
 Office of Land & Water Resources

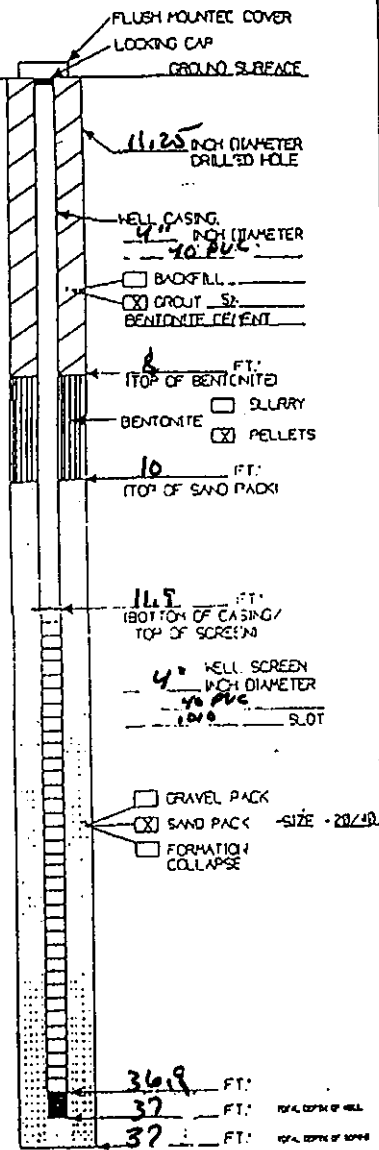

NOTE: ALL DEPTHS MEASURED RELATIVE TO GROUND SURFACE
 NM - NOT MEASURED