

LAWR.
G20

WATER WELL DRILLERS LOG

Date: 12-21-60, Driller: W J Fitzgerald ^{CODED 4-300} County: Lawrence
(Name)

(1) Owner of Land: Thomas Clay
(Name)
Monticello, Miss.
(Address)

(2) Location: SE 1/4, SE 1/4, Sec. 8 ^{N E} T. 1 R. 11,
2 miles N, of Monticello,
(distance) (direction) (Nearest Town)

(3) Topography: Flat
(Hilly) (Flat) (Level)

(4) Purpose of Well: Farm Use
(Domestic Irrigation
Municipal, Industrial, Other)

Description & Color of Materials Sand, Clay, Red Clay, Shell, etc.	Thick- ness Feet	Depth Feet
Sandy -	0	18
Sandy gravel	18	25
White Chalk	25	75
Sand	75	90
Blue shale	90	190
Fine Sand	190	285
Coarser Sand	285	310
Coarse Sand & Gravel	310	375

Information upon completion of well:

(1) Diameter 2 inches.

(2) Total Depth 371 feet.

(3) Water Level Artesian feet below top of ground.

(4) Cased to 351, Size 2"


(5) Screen: Size 1 1/4, Length 21'

(6) Were any formations sealed against pollution?
_____ yes, no.

If YES depth of formation _____

Why _____

Drillers Remarks: _____

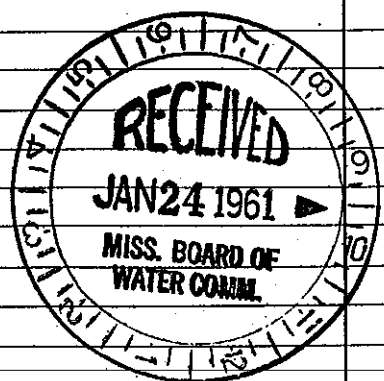

(Use Back Side)

Well No.

Mail this copy to Board of Water Commissioners 429 Miss. St. Jackson, Miss.