

Lawrence
H1
7-65

MISSISSIPPI BOARD OF WATER COMMISSIONERS

OK JGR

CODED

WATER WELL DRILLERS LOG

Date: 7-2-, 1965, Driller: Layne-Central Co. County Lawrence

(Name)

(1) Owner of Land: Town of Silver Creek
(Name)
Silver Creek, Mississippi
(Address)

(2) Location: 3 7-20W
1/4, 1/4, Sec. 3 T. R.
_____ miles _____ of _____
(distance) (direction) (Nearest Town)

(3) Topography: _____
(Hilly) (Flat) (Level)

(4) Purpose of Well: Municipal
(Domestic Irrigation
Municipal, Industrial, Other)

Description & Color of Materials Sand, Clay, Red Clay, Shell, etc.	Thick- ness Feet	Depth Feet
clay	26	26
sand & gravel	46	72
clay, stks sand	156	228
sand	6	234
clay-sand stks	31	265
sand	53	318
clay	73	391
sand	6	397
clay	44	441
sand, small clay stks	61	492
clay & shale	114	606
shale	51	657
fine sand, stks shale	29	686
sandy shale, stks sand	11	697
sand, stks shale	104	801

Information upon completion of well:

(1) Diameter 12 inches.

(2) Total Depth 801' 3" feet.

(3) Water Level 30' 6" feet below top of ground.

(4) Cased to 730', Size 8"


(5) Screen: Size 6", Length 35' 10"

(6) Were any formations sealed against pollution?
X yes, _____ no.

If YES depth of formation 730'

Why _____ required

Drillers Remarks: _____

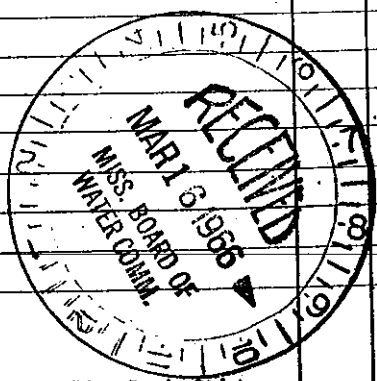

(Use Back Side)

Well No.

Mail this copy to Board of Water Commissioners 429 Miss. St. Jackson, Miss