

WATER WELL DRILLERS LOG

HOODED

H 12
9-19-60

Date: 9/19, 1960, Driller: James A. Hubert County: Lawrence
(Name)


(1) Owner of Land: Philip S. May
(Name)
Silver Creek
(Address)
(2) Location: NW 1/4, NW 1/4, Sec 10 T7R20
1 miles S of Silver Creek
(distance) (direction) (Nearest Town)
(3) Topography: (Hilly) (Flat) (Level)
(4) Purpose of Well:
(Domestic Irrigation
Municipal, Industrial, Other)

Description & Color of Materials Sand, Clay, Red Clay, Shell, etc.	Thick- ness Feet	Depth Feet
<u>Red Clay</u>	<u>20</u>	<u>20</u>
<u>Sand</u>	<u>18</u>	<u>38</u>
<u>water sand</u>	<u>16</u>	<u>54</u>

Information upon completion of well:

(1) Diameter 2 inches.
(2) Total Depth 60 feet.
(3) Water Level 38 feet below top of ground.
(4) Cased to 54, Size 2
(5) Screen: Size 1/4, Length 6 ft
(6) Were any formations sealed against pollution?
_____ yes, _____ no.

If YES depth of formation _____
Why _____
Drillers Remarks: _____

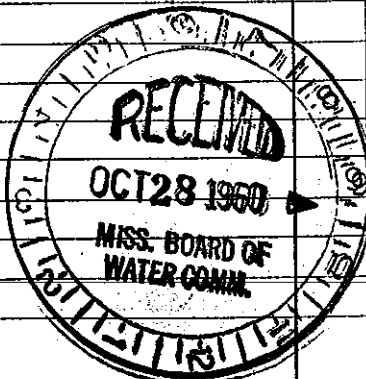

Well No.

(Use Back Side)