

LAWRENCE MISSISSIPPI BOARD OF WATER COMMISSIONERS

H 13

CODED 3

WATER WELL DRILLERS LOG

6-24-63

Date: 6/24, 1963, Driller: E. D. Dancy, County: Lincoln

(1) Owner of Land:	Description & Color of Materials Sand, Clay, Red Clay, Shell, etc.	Thick- ness Feet	Depth Feet
W M Hogg <small>(Name)</small> Rt-1-Box 6A Silver Creek <small>(Address)</small> Miss	Slsy Clay Sand	0 10	10 40
Location: SW 1/4, SE 1/4, Sec. 10, T. 7R20 2 miles South of Miss <small>(distance) (direction) (Nearest Town)</small>			
Topography: Hilly <small>(Hilly) (Flat) (Level)</small>			
Purpose of Well: Domestic <small>(Domestic Irrigation Municipal, Industrial, Other)</small>			


Information upon completion of well:

- (1) Diameter 6" inches.
- (2) Total Depth 40 feet.
- (3) Water Level 12 feet below top of ground.
- (4) Cased to 40, Size 4"
- (5) Screen: Size .10, Length 6'
- (6) Were any formations sealed against pollution?
 yes, no.

If YES depth of formation _____

Why _____

Drillers Remarks: _____

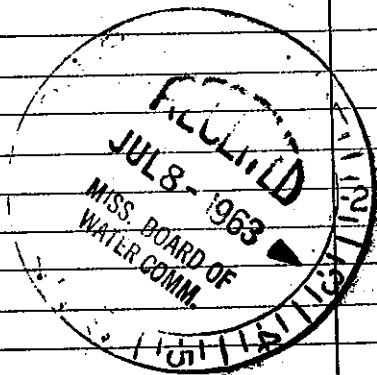

Well No.

(Use Back Side)

Mail this copy to Board of Water Commissioners 429 Miss. St. Jackson, Miss