

L.A.W.R.
J 4

WATER WELL DRILLERS LOG J

CODE B

Date: 10-61, 19__

Driller: *W. Ferguson*

(Name)

County: *Franklin*

(1) Owner of Land: *Louis E. Stevens*
(Name)

Rt. 2, Jayess, Mississippi
(Address)

(2) Location: $\frac{1}{4}$, $\frac{1}{4}$, Sec. 17 T. 6 R. 10, ^{North}

12 miles *SW* of *Monticello*
(distance) (direction) (Nearest Town)

(3) Topography: (Hilly) (Flat) (Level)

(4) Purpose of Well: *Domestic*
(Domestic Irrigation, Municipal, Industrial, Other)

Description & Color of Materials Sand, Clay, Red Clay, Shell, etc.	Thick- ness Feet	Depth Feet
<i>Top soil & clay</i>	<i>0</i>	<i>15</i>
<i>Red sand</i>	<i>15</i>	<i>40</i>
<i>Red sandy gravel</i>	<i>40</i>	<i>70</i>
<i>fine sand</i>	<i>70</i>	<i>85</i>
<i>White chalk</i>	<i>85</i>	<i>110</i>
<i>Red sandy gravel</i>	<i>110</i>	<i>140</i>
<i>fine sand</i>	<i>110</i>	<i>130</i>
<i>sand, brown layers</i>	<i>130</i>	<i>140</i>

Information upon completion of well:

(1) Diameter: *4* inches.

(2) Total Depth: *140* feet.

(3) Water Level: *90* feet below top of ground.

(4) Cased to: *135*, Size *4*

(5) Screen: Size *2*, Length *5 ft.*


(6) Were any formations sealed against pollution?
_____ yes, _____ no.

If YES depth of formation _____

Why _____

Drillers Remarks: _____

CODED

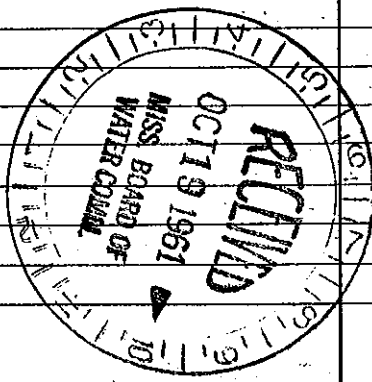

(Use Back Side)

Well No.

Mail this copy to Board of Water Commissioners 429 Miss. St. Jackson, Miss.