

Lawrence

J 5
11-66

MISSISSIPPI BOARD OF WATER COMMISSIONERS

CODED

WATER WELL DRILLERS LOG

Date: 11/10, 1966, Driller: T.B. Andrews County Lawrence
(When well drilled) (Name) (Where well is located)

(1) Owner of Land:	Description & Color of Materials Sand, Clay, Red Clay, Shell, etc.	Thick- ness Feet	Depth Feet
<u>James Calhoun</u> (Name)	<u>Red Clay</u>	<u>40</u>	<u>40</u>
<u>Rt. 2 Jayess, Miss.</u> (Address)	<u>Sand / gravel</u>	<u>50</u>	<u>90</u>
(2) Location: <u>NW 1/4, NW 1/4, Sec. 25 T6 N10</u>	<u>chalk</u>	<u>10</u>	<u>100</u>
<u>6 1/2</u> miles <u>S</u> of <u>Monticello</u> (distance) (direction) (Nearest Town)	<u>Sand / pea gravel</u>	<u>30</u>	<u>130</u>
(3) Topography: <u>Hilly</u> (Hilly) (Flat) (Level)			
(4) Purpose of Well: <u>Domestic</u> (Domestic Irrigation Municipal, Industrial, Other)			

Information upon completion of well:

- (1) Diameter _____ inches.
- (2) Total Depth 130 feet.
- (3) Water Level 100 feet below top of ground.
- (4) Cased to 130', Size 4"
- (5) Screen: Size 4", Length 6'
- (6) Were any formations sealed against pollution?
_____ yes, no.

If YES depth of formation _____


Why _____

Drillers Remarks: _____

Yield in gpm: 7

Size pump: 1 H.P

Type power: 220 Elec.

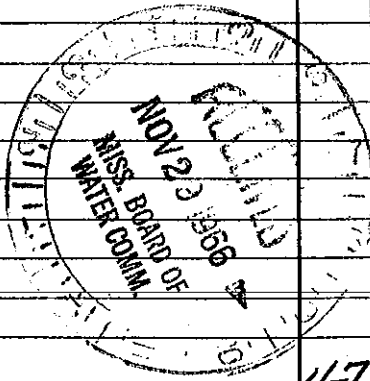

mail this copy to Board of Water Commissioners 429 Miss. St. Jackson, Miss.