

Lawrence
J 9
1-68

MISSISSIPPI
BOARD OF WATER COMMISSIONERS
416 North State Street
Jackson, Mississippi 39201

CODED

WATER WELL DRILLERS LOG

1-36 1968 Fitzgerald Well Service Company
date well completed firm name county well located

LANDOWNER: Jack Williamson
Monticella Rt Miss
(mailing address)

description of formations encountered	from	to
Top Silty clay	0	20
Red sand	20	60
Heavy gravel	60	70
White Chalk	70	140
Fine sand	140	160
Gravel	160	175
Soapy Sand		

WELL LOCATION:
sec. 5 T. 6 N. R. 10 E
9 miles WSW of Monticella
(distance) (direction) (nearest town)

WELL PURPOSE: home
(home, irrigation, municipal, industrial)

WELL COMPLETION DATA:

(1) diameter (inches) 4

(2) total depth (feet) 175

(3) static water level (feet) 80 below/above top of ground.

(4) casing plastic, 169,
(material) (depth)

4 If telescope see back.
(size)

(5) screen 6', 169
(length) (depth to top)

1/4", 50# 40
(size) (material)


(6) pump 1/4 Sub, 10
(HP) (yield gpm)

Elec
(type power)

(7) electric log no
(yes or no)

(organization running log)

(8) how well bottom plugged plugged

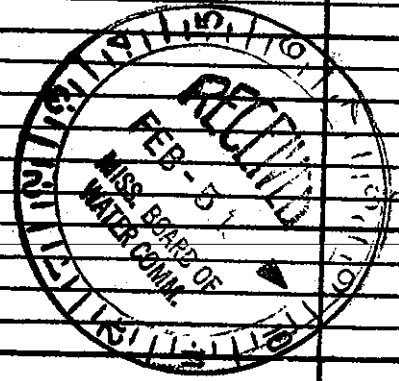

DRILLERS REMARKS: