
State Well	Report For Office Use Only:
County: Lawrence Part	
Permit #: Mississippi Department of Office of Land and	Water Resources 7.21
Driller GRENN WATER WELL & P.O. Box	
SUPPLY, INC. J. Jackson, MS 3	
Date drilling completed:	
State Law requires that this report be prepared by the dri 30 days of completion of drilling of the well.	
Well Owner Information	Well Location
Owner Name Chuck Musia La	atitude: <u>31• 30• 768</u> " Longitude: <u>90• 11• 94</u>
Mailing Address: P. O. Box 949 M	ethod of Lat/Long (circle one): Conventional Survey,
	USGS quad, Hand-heid GPS Survey-grade GPS
Mi II JOICH	SW14 SE 4 Sec 4 Twn 6N Rng DE
Monticello MS 39654 City State Zip Code	<u>DU/4_JE/4_Sec7_V</u> Twn_ <u>UV</u> Rng_ <u>UE</u>
	istance Direction Nearest Town <u>5</u> Miles <u>5</u> of <u>Montice//0</u>
Well Data	a
Purpose of Well (circle one) Home Industrial Public Supply In	rrigation Fish Culture Other: <u>540P</u>
	drilling completed: 3/10/05
If flowing, method of flow regulation: Valve Other (desc	<i>, , ,</i>
Static Water Level: feet above or below (circle one) land	l surface Date measured: <u>3/10/0.5</u>
Method of Measurement (circle one) steel tape electric tape	air line other:
Hole depth: <u>145</u> Well depth: <u>140</u>	Well grouted to a depth offeet
Type of grout (circle one): Cement Bentonite Mix	\wedge
Casing length: 130 feet Casing diameter: 4	inches Type of casing:
Screen length:feet Screen diameter:4	inches Type of screen: <u>PVC</u>
Screen slot size:inches Setting depth: From	<u>30</u> feet to <u>140</u> feet
Type of completion (circle all applicable): Gravel packed Underrea	
	me recorder the new range recordenter
Other (describe):	
Top of lap pipe or reduction in casing:fect. If teles	coped or more than one screen, describe on back of page
Logs run (circle all applicable): No log run Electric Gamma Ray I	Density Sonic Neutron Other:
Name of organization running log(s):	
I certify that the well was drilled, constructed, and completed in according to the second se	
Department of Environmental Quality and/or the Mississippi Depart GRENN WATER WELL & SUPPLY, INC.	ment of Health regulations and state laws.
Brian McClendon, lic. no. 0-664	Rain Melling
Print Name of Water Well Contractor and License No.	Signature of Water Well Contractor
	RECEI
	MAR 2.2
•	BY: OL

		••
BY:	OLW	/R
		5 G N
		•

If well telescopes please sketch below and show depths.

Ground Level J= 31	Description of Formations Encountered	From	To
	red claw/gravel	0	<u>17</u>
	Sand		3心
	white clay	30	X
	50 MM	182	14
	white clay	140	14
			_
		<u> </u>	
	· · · · · · · · · · · · · · · · · · ·		
	,		
•			
	· · · · · · · · · · · · · · · · · · ·		
	L	!	L

If more than one screen, show location of each on sketch

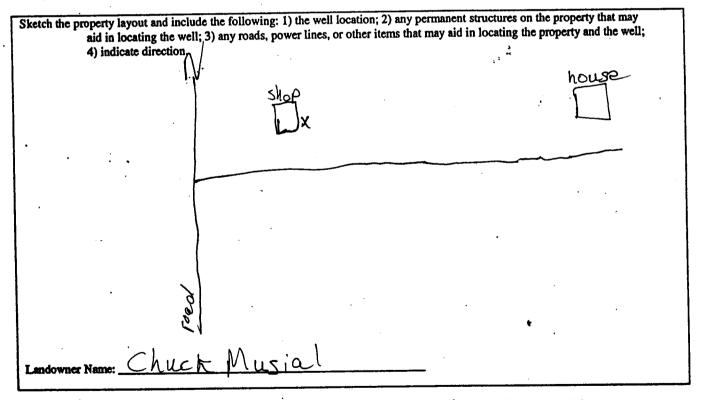

Brian McClendon, lic. no. 0-664 GRENN WATER WELL & SUPPLY, INC.

Signature of Water Well Contractor

STATE WELL REPORT		
County: Lawience Permit #: Pump Installer Mississippi Department Office of Land Driller: Grenn Water Wall Date completed: 3/14/05	Part 2 is Completion Report int of Environmental Quality and Water Resources Box 10631 MS 39289-0631 0961-5210 64-6938 (fax) Il and filed with the Department within 30 days of the	
installation of pump. Well Owner Information		
	Well Location	
Owner Name: Chuck Musial	Latitude: 31 30 768 Longitude: 90 11 947	
Mailing Address: <u>P.C. Box 949</u>	Method of Lat/Long (circle one): Conventional Survey,	
·	USGS quad, (Hand-held GPS,) Survey-grade GPS	
Monticello M5 39654 City State Zip Code	SW 14 SF 14 Sec 4 Twn GN Rng 10E	
City State Zip Code	Distance Direction Nearest Town	
(1) 507 600 (
Telephone No. (601) 587-0225	5 Miles SW of Monticello	
Ритр Туре	Dama au Dama	
Circle one	Power Type Circle one	
Air Lift Jet Submersible	Diesel Engine Gasoline Engine Natural Gas	
Bucket Piston Turbine	Electric Motor Hand Tractor PTO	
Centrifugal Rotary Flowing Well	Windmill Other (specify):	
Other (specify):	Horse Power Rating of Motor:	
Date Pump Installed: 3/14/05	Setting Depth: 80 feet	
Rated Pump Capacity: Ø Gallons Per Minute	Number of Stages:9	
Pump Test Data	Method of Measuring Water Level	
Date Well Tested: 3/14/05	Circle one	
· · · · · · · · · · · · · · · · · · ·	Air Line Electric Measuring Line Steel Tape	
Static Water Level (A): <u>50</u> Feet Below Land Surface	Other (specify):	
Pumping Water Level (B): 52 Feet Below Land Surface		
Drawdown [(B) - (A)]:Feet Below Land Surface	For flowing well, measured shut in head:feet	
Test Pumping Rate: Gallons Per Minute	Well yielded <u>12</u> GPM with a drawdown of	
Duration of Pump Test (minimum 4 hours):	feet after hours of pumping	
I HEREBY CERTIFY that the above statements are true to the best of my knowledge. GRENN WATER WELL & SUPPLY, INC. William Hardin, lic. no. 0-717P Print Name of Pump Installer and License No. (if applicable) Signature of Pump Installer RECEIVE		
	nevelve	

MAR 2 2 2005 BY: OLWR