

State Well Report

Part 1

Mississippi Department of Environmental Quality
Office of Land and Water Resources
P.O. Box 10631
Jackson, MS 39289-0631
(601)961-5210
(601)354-6938 (fax)

For Office Use Only:

Aquifer: _____
Well #: J-34
L. S. Elevation: _____
E-log #: _____

County: Lawrence
Permit #: _____
Driller: GRENN WATER WELL & SUPPLY, INC.
Date drilling completed: 6/22/05
7/5/05

State Law requires that this report be prepared by the driller in detail and filed with the Department within 30 days of completion of drilling of the well.

Well Owner Information	Well Location
Owner Name: <u>Doug Koonce</u>	Latitude: <u>31° 30' 931"</u> Longitude: <u>90° 9' 365"</u>
Mailing Address: <u>11 Earl D Russell Sr Cr</u>	Method of Lat/Long (circle one): <u>Conventional Survey</u>
<u>Monticello MS 39654</u>	USGS quad: <u>Hand-held GPS</u> Survey-grade GPS
City State Zip Code	<u>NW 1/4 NW 1/4 Sec 1</u> Twn <u>6N</u> Rng <u>10E</u>
Telephone No. <u>(225) 247-2727</u>	Distance <u>3</u> Miles Direction <u>SW</u> of Nearest Town <u>Monticello</u>

Well Data

Purpose of Well (circle one) Home Industrial Public Supply Irrigation Fish Culture Other: _____

Date well drilling started: 6/22/05 7/5/05 Date well drilling completed: 6/22/05 7/5/05

If flowing, method of flow regulation: Valve _____ Other (describe) _____

Static Water Level: 100 feet above of below (circle one) land surface Date measured: 6/22/05 7/5/05

Method of Measurement (circle one) steel tape electric tape air line other: _____

Hole depth: 290 Well depth: 275 Well grouted to a depth of 10 feet

Type of grout (circle one): Cement Bentonite Mix

Casing length: 255 feet Casing diameter: 4 inches Type of casing: PVC

Screen length: 20 feet Screen diameter: 4 inches Type of screen: PVC

Screen slot size: 10/10 inches Setting depth: From 255 feet to 275 feet

Type of completion (circle all applicable): Gravel packed Underreamed Telescoped Open hole Natural Development

Other (describe): _____

Top of lap pipe or reduction in casing: _____ feet. If telescoped or more than one screen, describe on back of page

Logs run (circle all applicable): No log run Electric Gamma Ray Density Sonic Neutron Other: _____

Name of organization running log(s): _____

I certify that the well was drilled, constructed, and completed in accordance with all applicable requirements of the Mississippi Department of Environmental Quality and/or the Mississippi Department of Health regulations and state laws.

GRENN WATER WELL & SUPPLY, INC.
Brian McClendon, lic. no. 0-664

Brian McClendon
Signature of Water Well Contractor


Print Name of Water Well Contractor and License No.

RECEIVED
JUL 25 2005
BY: OLWR

If well telescopes please sketch below and show depths.

J-34


Ground Level

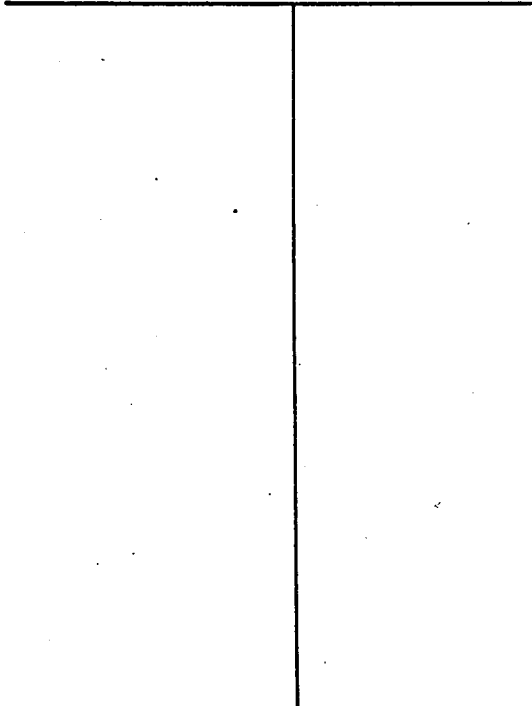

Description of Formations Encountered	From	To
gravel	0	12
white clay	12	35
blue clay	35	120
clay / sand streaks	120	140
sand blue clay	140	255
sand	255	275
blue clay	275	390

If more than one screen, show location of each on sketch

Sketch the property layout and include the following: 1) the well location; 2) any permanent structures on the property that may aid in locating the well; 3) any roads, power lines, or other items that may aid in locating the property and the well; 4) indicate direction.

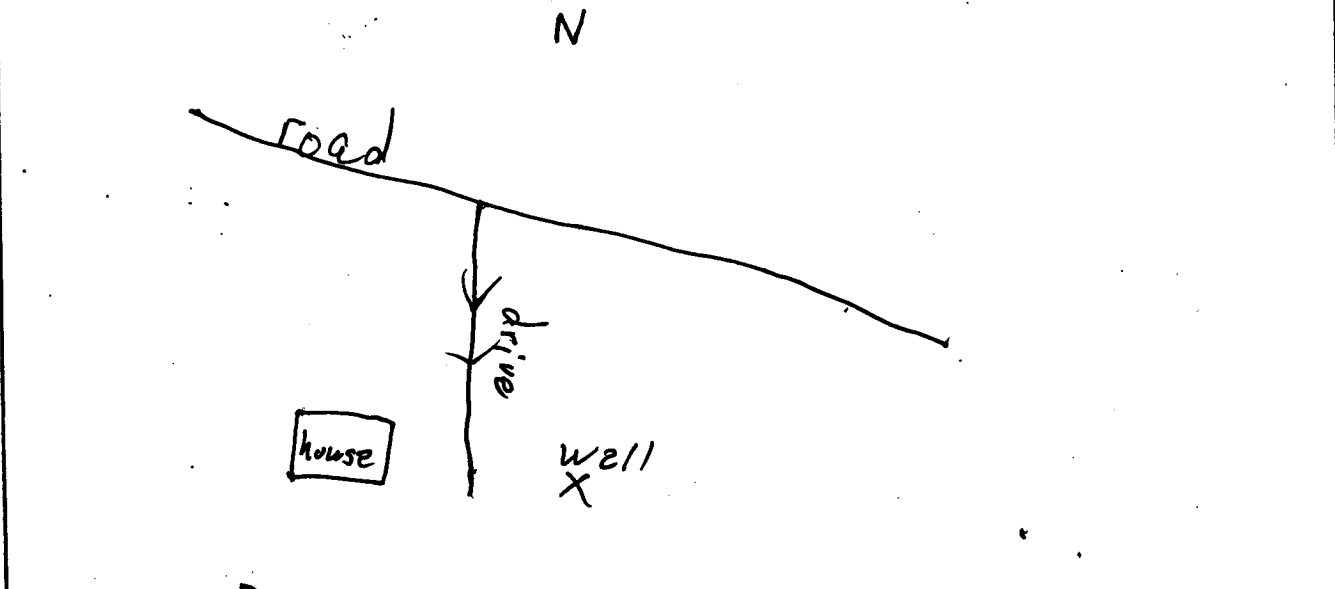

Landowner Name: Doug Koonce

Brian McClendon, lic. no. 0-664
GRENN WATER WELL & SUPPLY, INC.

Brian McClendon
Signature of Water Well Contractor

STATE WELL REPORT

Part 2

Pump Installer's Completion Report
 Mississippi Department of Environmental Quality
 Office of Land and Water Resources
 P.O. Box 10631
 Jackson, MS 39289-0631
 (601)961-5210
 (601)354-6938 (fax)

County: Lawrence
 Permit #: _____
 Driller: GRENN WATER WELL & SUPPLY, INC.
 Date completed: 7/12/05

For Office Use Only:

Aquifer: _____
 Well #: J-34
 Elevation: _____

This report should be prepared by the pump installer in detail and filed with the Department within 30 days of the installation of pump.

Well Owner Information	Well Location
Owner Name: <u>Doug Koance</u>	Latitude: <u>31°30'931"</u> Longitude: <u>90°9'365"</u>
Mailing Address: <u>11 Earl D Russell Sr Cr</u>	Method of Lat/Long (circle one): Conventional Survey,
<u>Monticello MS 39654</u>	USGS quad, <u>(Hand-held GPS)</u> Survey-grade GPS
City State Zip Code	<u>NW ¼ NW ¼ Sec 1 Twn 6N Rng 10E</u>
Telephone No. <u>(225) 247-2727</u>	Distance Direction Nearest Town
	<u>3 Miles SW of Monticello</u>

Pump Type Circle one	Power Type Circle one
Air Lift Jet <input type="radio"/> <u>Submersible</u>	Diesel Engine Gasoline Engine Natural Gas
Bucket Piston <input type="radio"/> Turbine <input type="radio"/>	<u>Electric Motor</u> Hand <input type="radio"/> Tractor PTO <input type="radio"/>
Centrifugal Rotary <input type="radio"/> Flowing Well <input type="radio"/>	Windmill Other (specify): _____
Other (specify): _____	Horse Power Rating of Motor: <u>3/4</u>
Date Pump Installed: <u>7/12/05</u>	Setting Depth: <u>140</u> feet
Rated Pump Capacity: <u>10</u> Gallons Per Minute	Number of Stages: <u>12</u>

Pump Test Data	Method of Measuring Water Level Circle one
Date Well Tested: <u>7/12/05</u>	Air Line <input type="radio"/> <u>Electric Measuring Line</u> <input type="radio"/> Steel Tape <input type="radio"/>
Static Water Level (A): <u>100</u> Feet Below Land Surface	Other (specify): _____
Pumping Water Level (B): <u>110</u> Feet Below Land Surface	For flowing well, measured shut in head: _____ feet
Drawdown [(B) - (A)]: <u>10</u> Feet Below Land Surface	Well yielded <u>12</u> GPM with a drawdown of
Test Pumping Rate: <u>12</u> Gallons Per Minute	<u>10</u> feet after <u>4</u> hours of pumping
Duration of Pump Test (minimum 4 hours): <u>4</u> hours	

I HEREBY CERTIFY that the above statements are true to the best of my knowledge.

GRENN WATER WELL & SUPPLY, INC.
 William Hardin, lic. no. 0-717P
 Print Name of Pump Installer and License No. (if applicable)

William Hardin
 Signature of Pump Installer

RECEIVED

JUL 25 2005

BY: OLWR