

11/5

# STATE WELL REPORT

## Part 1

### Driller's Log

Mississippi Department of Environmental Quality  
Office of Land and Water Resources  
P.O. Box 2309  
Jackson, MS 39225-2309  
(601)961-5210  
(601)360-0535 (fax)

#### For Office Use Only:

Well #: J52  
Aquifer: \_\_\_\_\_  
E-Log #: \_\_\_\_\_

County: Lawrence  
Permit #: \_\_\_\_\_  
Driller: James M. Wells  
Date drilling completed: 9-4-14

State Law requires that this report be prepared by the license holder responsible for the work and filed with the Department at the above address within 30 days of completion of drilling of the well or borehole.

#2

Well Owner Information (Landowner if borehole is not for a water well)	Well or Borehole Location
Owner Name: <u>Alex Russell</u>	Latitude: <u>31°29.944</u> Longitude: <u>090°11.241</u>
Mailing Address: <u>PO Box 1100</u>	Method of Lat/Long (check one): Conventional Survey _____, USGS quad _____, Hand-held GPS _____, Survey-grade GPS _____
<u>Monticello</u> <u>MS</u> <u>39654</u> City State Zip Code	<u>SE</u> 1/4 <u>SW</u> 1/4, Sec <u>10</u> T <u>6N</u> R <u>10E</u>
Telephone No. <u>(601) 748-6505</u>	<u>10</u> Miles <u>Sw</u> of <u>Monticello</u> (Distance) (Direction) (Nearest Town)

**Well / Borehole Data**

Date drilling started: 9-4-14 Date drilling completed: 9-4-14 Hole depth: 185 Hole diameter: 7 1/2"

Location of the source of any surface water used for drilling: Running creek

Method of dosing and volume of Chlorine used in drilling and development: granule chlorine

Logs run (circle all applicable):  No log run  Electric  Gamma Ray  Density  Sonic  Neutron Other: \_\_\_\_\_

Name of organization running log(s): \_\_\_\_\_

Purpose of borehole (circle one):  Water Well  Geotechnical/Geological Investigation  Ground Source Heat Pump  
 Seismic Survey  Other (describe) \_\_\_\_\_

*If drilling is not related to water well construction, skip the remainder of this block*

Purpose of Well (circle all applicable): Home Industrial Public Supply Irrigation Fish Culture  
Other (describe): poultry farm

If a flowing well, method of flow regulation: Valve \_\_\_\_\_ Other (describe) \_\_\_\_\_

Static Water Level: 80 feet [above or  below] land surface Date measured: 9-4-14  
(circle one)

Method of measurement (circle one):  Steel tape  Electric tape  Air line Other (describe): \_\_\_\_\_

Well depth: 185 Well grouted to a depth of: 10 feet Type of grout (circle one):  Neat Cement  Bentonite Mix

Casing length: 155 feet Casing diameter: 4 inches Type of casing: PVC

Screen length: 30 feet Screen diameter: 4 inches Type of screen: PVC

Screen slot size: .008 inches Setting depth: From 155 feet to 185 feet

Type of completion (circle all applicable):  Gravel pack  Underreamed  Open hole  Natural Development

Other (describe): \_\_\_\_\_

Top of lap pipe or reduction in casing: \_\_\_\_\_ feet

If telescoped or more than one screen, describe on next page


RECEIVED  
OCT 27 2014

County: Lawrence  
Permit #: \_\_\_\_\_

**For Office Use Only:**  
Well #: J52

*The sketch below only required for water wells*

*If well telescopes, show depths on sketch.*

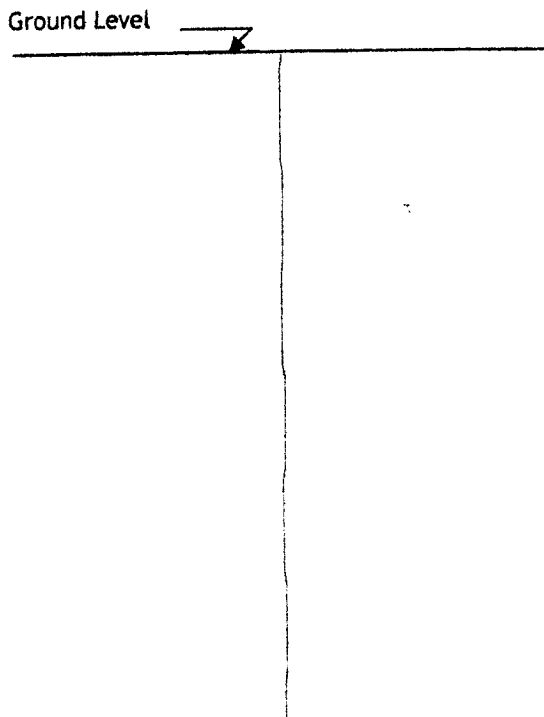

**Description of formations encountered must be provided for all wells and boreholes, unless specifically exempted by regulations**

Description of Formations Encountered	From (depth)	To (depth)
top soil	Ground level	1
clay	1	125
sand	125	185

If more than one screen, show location of each on sketch

Sketch the property layout and include the following:  
1) the well location  
2) any permanent structures on the property that may aid in locating the well  
3) any roads, power lines, or other items that may aid in locating the property and the well  
4) north arrow

Landowner Name: Alex Russell

**RECEIVED**  
**OCT 27 2014**  
**BY: OLWR**

I HEREBY CERTIFY that the well/borehole was drilled, constructed, and completed in accordance with all applicable requirements of the Mississippi Department of Environmental Quality and the Mississippi Department of Health regulations, if applicable, and state laws.

James M. Wells 00005889 10-23-14 James M. Wells  
Print Name of Responsible Licensee and License No. Date Signature of Licensee

# STATE WELL REPORT

## Part 2

**Pump Installer's Completion Report**  
 Mississippi Department of Environmental Quality  
 Office of Land and Water Resources  
 P.O. Box 2309  
 Jackson, MS 39225-2309  
 (601)961-5210  
 (601) 360-0535 (fax)

County: Lawrence  
 Permit #: \_\_\_\_\_  
 Driller: James M. Wells  
 Date completed: 9-4-14  
Copy information from block on Part 1

**For Office Use Only:**

Well #: J52  
 Aquifer: \_\_\_\_\_

*This part of the report must be completed by a licensed water well contractor or a licensed pump installer. A copy of Part 1 of the report must be attached and both parts filed with the Department at the above address within 30 days of well completion.*

Well Owner Information	Well Location
Owner Name: <u>Alex Russell</u>	Latitude: <u>31°29.944</u> Longitude: <u>090°11.241</u>
Mailing Address: <u>PO Box 1100</u>	Method of Lat/Long (check one): Conventional Survey _____, <sup>57</sup> USGS quad _____, Hand-held GPS _____, <sup>14</sup> Survey-grade GPS _____
<u>Monticello</u> <u>MS</u> <u>39654</u>	<u>SE</u> $\frac{1}{4}$ <u>SW</u> $\frac{1}{4}$ , Sec <u>10</u> T <u>6N</u> R <u>10E</u>
City State Zip Code	<u>10</u> Miles <u>Sw</u> of <u>Monticello</u>
Telephone No. (601) <u>748-6505</u>	(Distance) (Direction) (Nearest Town)

**Pump Type (circle one)**

Submersible  Turbine  Air Lift  Centrifugal  Flowing Well  Jet  Piston  Rotary  Other (describe): \_\_\_\_\_

Date Pump Installed: 9-4-14 Rated Pump Capacity: 35 Gallons Per Minute

Is This Pump (circle one):  New  Repaired  Replacement

**Power Type (circle one)**

Electric  Diesel  Gasoline  Natural Gas  Tractor PTO  Windmill  Other (describe): \_\_\_\_\_

Horse Power Rating of Motor: 3 Setting Depth: 150 feet Number of Stages: 11

**Pump Test Data for Non Flowing Well**

Date Well Tested: 9-4-14 Duration of Pump Test (minimum 4 hours): 4 hours

Static Water Level (A): 80 Feet Below Land Surface Pumping Water Level (B): 150 Feet Below Land Surface

Drawdown [(B) - (A)]: 92 Feet Below Land Surface Test Pumping Rate: 45 Gallons Per Minute

Method of measurement (circle one):  Steel tape  Electric tape  Air line  Other (describe): \_\_\_\_\_

**Pump Test Data for Flowing Well**

Measured shut in head: \_\_\_\_\_ feet.

Well yielded \_\_\_\_\_ GPM with a drawdown of \_\_\_\_\_ feet after \_\_\_\_\_ hours of pumping

**Meter Installation**

Meter Manufacturer: \_\_\_\_\_ Meter Serial Number: \_\_\_\_\_

Meter Model Number/Name: \_\_\_\_\_ Type of Meter: \_\_\_\_\_

Totalizer Register Unit and Multiplier Factor (AF x .001, gal x 1000, etc): \_\_\_\_\_

Installation Date: \_\_\_\_\_ Meter installed by: \_\_\_\_\_

Is This Meter (circle one):  New  Repaired  Replacement

**RECEIVED**  
OCT 27 2014  
BY: OLWR

*Important: By submitting the above information you are certifying that this meter was installed to manufacturer standards. For agricultural wells, a list of approved meters is on the MDEQ website.*

I HEREBY CERTIFY that the above statements are true to the best of my knowledge.

James M. Wells 00005889 10-23-14 James M. Wells  
 Print Name of Pump Installer and License No. (if applicable) Date Signature of Pump Installer