

LAURENCE
 5
 2015

MISSISSIPPI
 BOARD OF WATER COMMISSIONERS
 416 North State Street
 Jackson, Mississippi 39201

WATER WELL DRILLERS LOG

10/20/85

Tom Griffith Wellser

Lawrence

date well completed

firm name

county well located

LANDOWNER: Eddie Reynolds

Rt. 2 Box 83

Jayess

(mailing address)

WELL LOCATION:

sec. 34 T 6 N R 10 E

3 miles NW of Divide
 (distance) (direction) (nearest town)

WELL PURPOSE: home
 (home, irrigation, municipal, industrial)

WELL COMPLETION DATA:

- (1) diameter (inches) 4"
- (2) total depth (feet) 180'
- (3) static water level (feet) 120' ^{6' above} top of ground.

(4) casing PVC, 160'
 (material) (depth)

NA if telescope see back.
 (size)

(5) screen 20', 160'
 (length) (depth to top)

4" PVC
 (size) (material)

(6) pump 3/4 HP, 12
 (HP) (yield gpm)

Elec.
 (type power)

(7) electric log NO
 (yes or no)

NA
 (organization running log)


(8) how well bottom plugged 3UN.

description of formations encountered

from

to

Clay	1	10
Red-Sand	10	20
P-gravel	20	90
Clay	90	110
rock	110	112
P-gravel	112	180

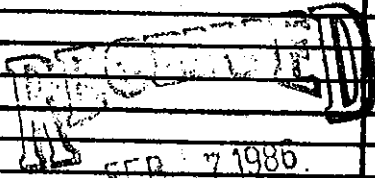

Department of Natural Resources
 Bureau of Land & Water Resources

DRILLERS REMARKS: