

LAWRENCE

MISSISSIPPI BOARD OF WATER COMMISSIONERS

K6

CODED

8-16-66

WATER WELL DRILLERS LOG

Date: 8/16, 1966, Driller: T. B. Anderson County LAWRENCE

(Name)

(1) Owner of Land: Wilburn Martin
 (Name)
Jayess, Miss Rt. 2
 (Address)

(2) Location: 1/4, SE 1/4, Sec. 24 T. 6 R. 11
6 miles S of Monticello
 (distance) (direction) (Nearest Town)

(3) Topography: Hilly
 (Hilly) (Flat) (Level)

(4) Purpose of Well: Domestic
 (Domestic Irrigation
 Municipal, Industrial, Other)

Description & Color of Materials Sand, Clay, Red Clay, Shell, etc.	Thick- ness Feet	Depth Feet
Red clay	20	20
Sand/gravel	40	60
Dark clay/Chalk	40	100
Sand / pea gravel	20	120

CODED

Information upon completion of well:

(1) Diameter 4 inches.

(2) Total Depth 120 feet.

(3) Water Level 100 feet below top of ground.

(4) Cased to 120', Size 4"


(5) Screen: Size 4", Length 6"

(6) Were any formations sealed against pollution?
 _____ yes, no.

If YES depth of formation _____

Why _____

Drillers Remarks: Plastic well
Subm. pump.

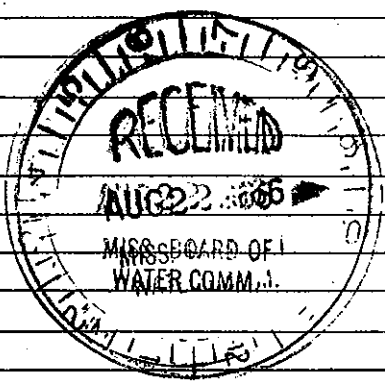

33

Well No.

(Use Back Side)