

MISSISSIPPI BOARD OF WATER COMMISSIONERS

CODED

WATER WELL DRILLERS LOG


Lawrence  
K7  
10-66

Date: 10/7, 1966, Driller: T. B. Andrews County LAWRENCE  
(Name)

(1) Owner of Land:	Description & Color of Materials Sand, Clay, Red Clay, Shell, etc.	Thick- ness Feet	Depth Feet
<u>Gilbert Case</u> (Name)	<u>Blue Clay</u>	<u>90'</u>	<u>90'</u>
<u>Rt. 2 Monticello, Miss.</u> (Address)	<u>Sand</u>	<u>20'</u>	<u>110'</u>
(2) Location: <u>NW 1/4, NW 1/4, Sec. 22 T6 R11</u>	<u>Blue Clay</u>	<u>300'</u>	<u>410'</u>
<u>6</u> miles <u>S.E.</u> of <u>Monticello</u>	<u>Sand</u>	<u>40'</u>	<u>450'</u>
(3) Topography: <u>Hilly</u> (Hilly) (Flat) (Level)			
(4) Purpose of Well: <u>Domestic</u> (Domestic Irrigation Municipal, Industrial, Other)			

Information upon completion of well:

- (1) Diameter 2 inches.
- (2) Total Depth 450 feet.
- (3) Water Level 400 feet below top of ground.
- (4) Cased to 450', Size 2"
- (5) Screen: Size 2", Length 5'
- (6) Were any formations sealed against pollution?  
no.

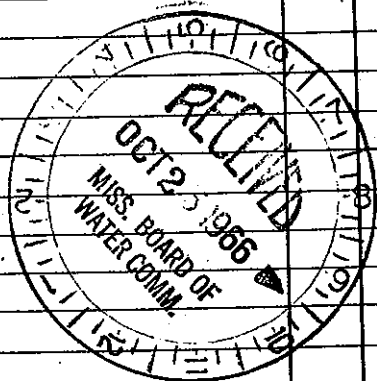

If YES depth of formation \_\_\_\_\_  
Why \_\_\_\_\_  
Drillers Remarks: \_\_\_\_\_

Galvanized pipe  
well  
Water level is 300 about  
well flowed 3/4" stream 37 ft.

Well No. 41

(Use Back Side)

Mail this copy to Board of Water Commissioners 429 Miss. St. Jackson, Miss.