

LAWRENCE


L 2007

2-13-81

3-13-81

MISSISSIPPI  
BOARD OF WATER COMMISSIONERS  
416 North State Street  
Jackson, Mississippi 39201

WATER WELL DRILLERS LOG

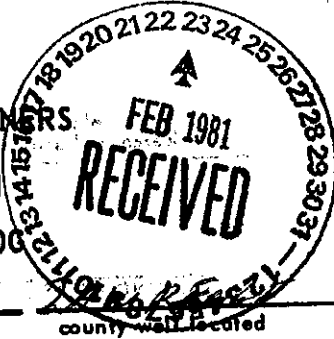

TOM GRIFFITH

firm name

county well located

date well completed

LANDOWNER:	description of formations encountered	from	to
JACK LEONARD Rt. 1, ARN (mailing address)			
<b>WELL LOCATION:</b>			
sec. 3 T 6 N R 20 E S W			
2 miles N of ARN (distance) (direction) (nearest town)			
<b>WELL PURPOSE:</b> HOME (home, irrigation, municipal, industrial)			
<b>WELL COMPLETION DATA:</b>			
(1) diameter (inches) 2"			
(2) total depth (feet) 60'			
(3) static water level (feet) 35' below top of ground.			
(4) casing PLASTIC, 60' (material) (depth)			
2" (size) if telescope see back.			
(5) screen 10' 50' (length) (depth to top)			
2" PLASTIC (size) (material)			
(6) pump 3/4 (HP) 8 (yield gpm)			
PHI (type power)			
(7) electric log NO (yes or no)			
(organization running log)			
(8) how well bottom plugged BWV			
<b>DRILLERS REMARKS:</b>			

DEPT. OF NATURAL RESOURCES  
BUREAU OF LAND & WATER RESOURCES

