

LAWR. MISSISSIPPI BOARD OF WATER COMMISSIONERS

JMI  
11-16-62

WATER WELL DRILLERS LOG

OKDUB  
CODED

Date: 11-16, 1962, Driller: Chester Reeves County Lawrence

(Name)

(1) Owner of Land:	Description & Color of Materials Sand, Clay, Red Clay, Shell, etc.	Thick- ness Feet	Depth Feet
D.J. Sandifer (Name)	Red clay	25	25
RFD, Jayess (Address)	Red sand & small gravel	65	90
(2) Location: 1/4, 1/4, Sec. 10 510 E T R	Hard gravel & sand	12	102
8 miles NIE, of Ruth (distance) (direction) (Nearest Town)			
(3) Topography: Hilly (Hilly) (Flat) (Level)			
(4) Purpose of Well: Domestic (Domestic Irrigation Municipal, Industrial, Other)			

Information upon completion of well:

(1) Diameter 4 inches.

(2) Total Depth 102 feet.

(3) Water Level 90 feet below top of ground.

(4) Cased to Baffan Size 4"


(5) Screen: Size 4", Length 4'

(6) Were any formations sealed against pollution?  
 yes,  no.

If YES depth of formation \_\_\_\_\_

Why \_\_\_\_\_

Drillers Remarks: New House

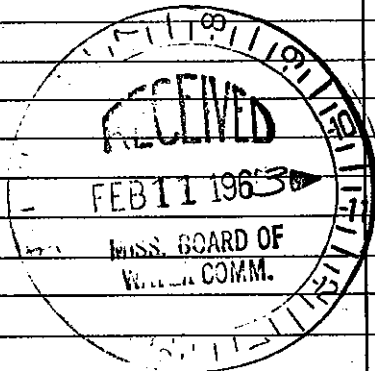

REEVES WELL & PUMP CO.  
P. O. BOX 71 -- PHONE 634-1451  
McCOMB, MISS.

(Use Back Side)

Well No.

Mail this copy to Board of Water Commissioners 429 Miss. St. Jackson, Miss