

LAWR. MISSISSIPPI BOARD OF WATER COMMISSIONERS CODED

M3

WATER WELL DRILLERS LOG

M CODED

8-8-60

Date: 8-8, 1960, Driller: Chester Reeves County Lawrence

(Name)

(1) Owner of Land: <u>D. J. Jandifer</u> (Name)	Description & Color of Materials Sand, Clay, Red Clay, Shell, etc.	Thick- ness Feet	Depth Feet
<u>RFD Jayess, Miss</u> (Address)	<u>Red Clay</u>	<u>20</u>	<u>20</u>
(2) Location: <u>1/4, 1/4, Sec. 5 T12R5</u>	<u>Red sand & clay</u>	<u>70</u>	<u>97</u>
<u>100</u> miles <u>S.W.</u> , <u>Monticello</u> (distance) (direction) (Nearest Town)	<u>Small gravel & sand</u>	<u>19</u>	<u>169</u>
(3) Topography: <u>Hilly</u> (Hilly) (Flat) (Level)			
(4) Purpose of Well: <u>Domestic</u> (Domestic Irrigation Municipal, Industrial, Other)			

Information upon completion of well:

(1) Diameter 2 inches.

(2) Total Depth 169 feet.

(3) Water Level 85 feet below top of ground.

(4) Cased to 109, Size 2"


(5) Screen: Size 1 1/4, Length 6'

(6) Were any formations sealed against pollution?
 yes, no.

If YES depth of formation _____

Why _____

Drillers Remarks: _____

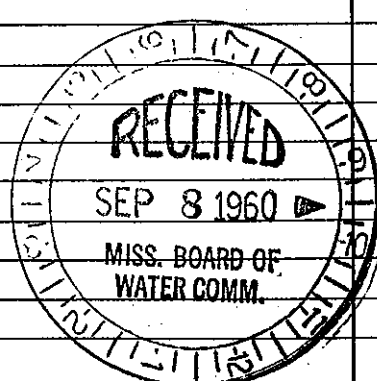

(Use Back Side)

Well No.

Mail this copy to Board of Water Commissioners 429 Miss. St. Jackson, Miss.